

G-8231


5

53475

T. 1 S. R. 24 E. W. M.



SCALE 1" = 1320'

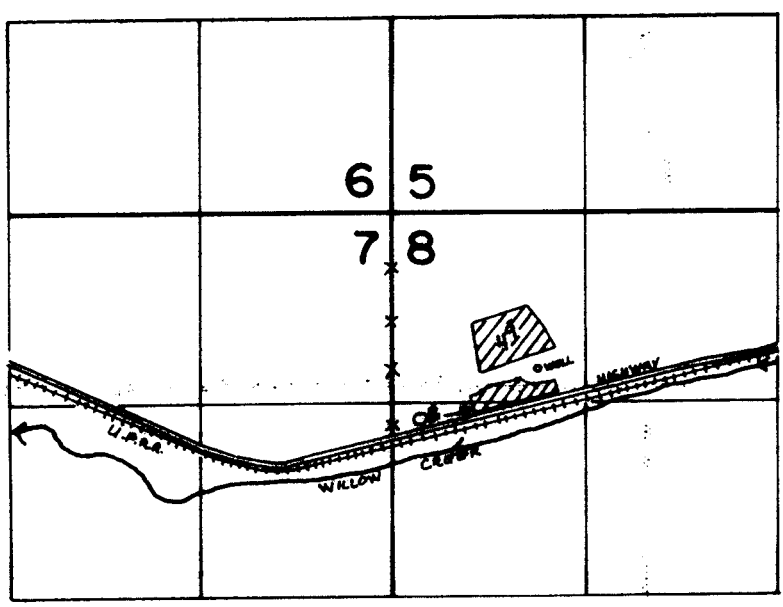

WELL LOCATED 1050' S. AND 1000' E. FROM NW. COR. SEC. 8

FINAL PROOF SURVEY UNDER

Application No. G-~~8526~~ Permit No. G-8231.....
IN NAME OF

HERBERT R. & PANSY EKSTROM.....

Surveyed JUNE 25... 1984.. by VI. CHURCH.....