


RECEIVED

APR 20 1984
WATER RESOURCES DEPT.
SALEM, OREGON

T.4S., R.10W., W.M.

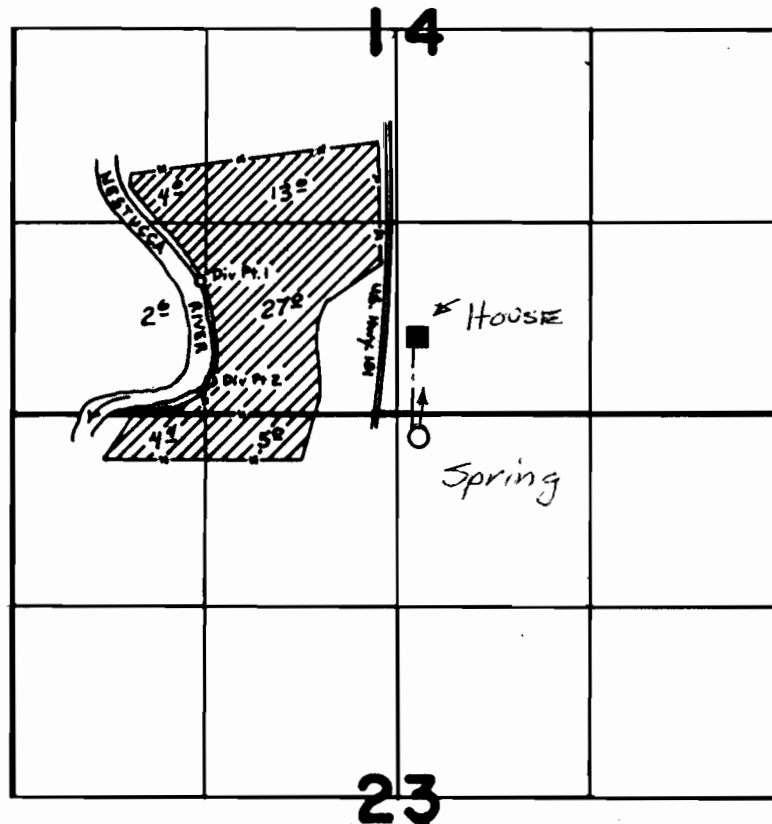

Spring Loc: 100 ft South and 100 ft East,
from the N 1/4 Corner Section 23

Application No. 68064
Permit No. 48472