


5

T. 4N., R. 29E., W. M.

G 5753

53479

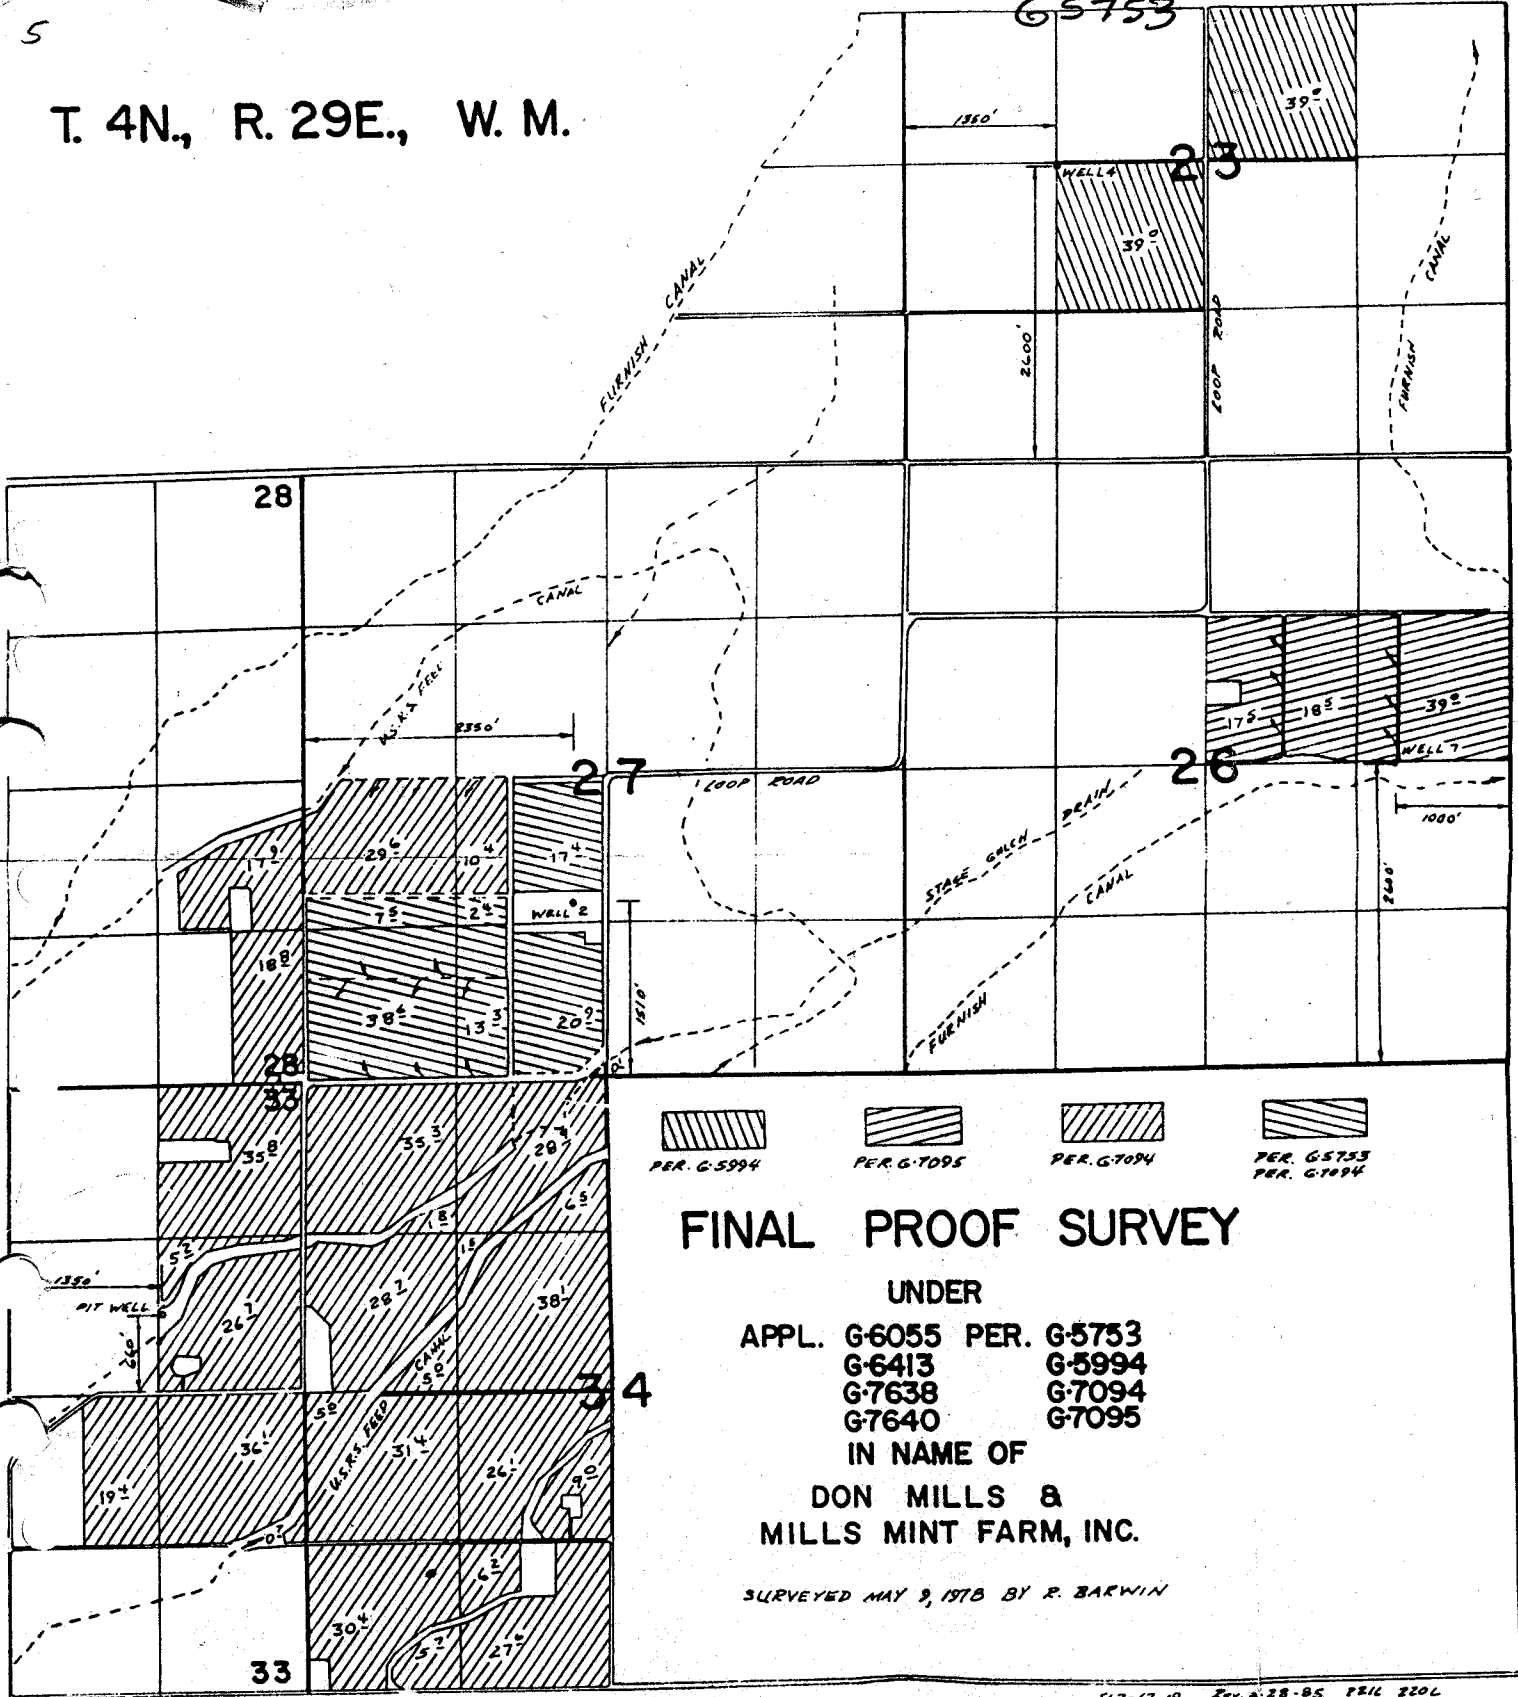

			
PER. G-5994	PER. G-7095	PER. G-7094	PER. G-5753 PER. G-7094

FINAL PROOF SURVEY

UNDER

APPL. G-6055 PER. G-5753
 G-6413 G-5994
 G-7638 G-7094
 G-7640 G-7095

IN NAME OF

**DON MILLS &
 MILLS MINT FARM, INC.**

SURVEYED MAY 9, 1978 BY R. BARWIN