T. 4N., R. 29E., W. M.

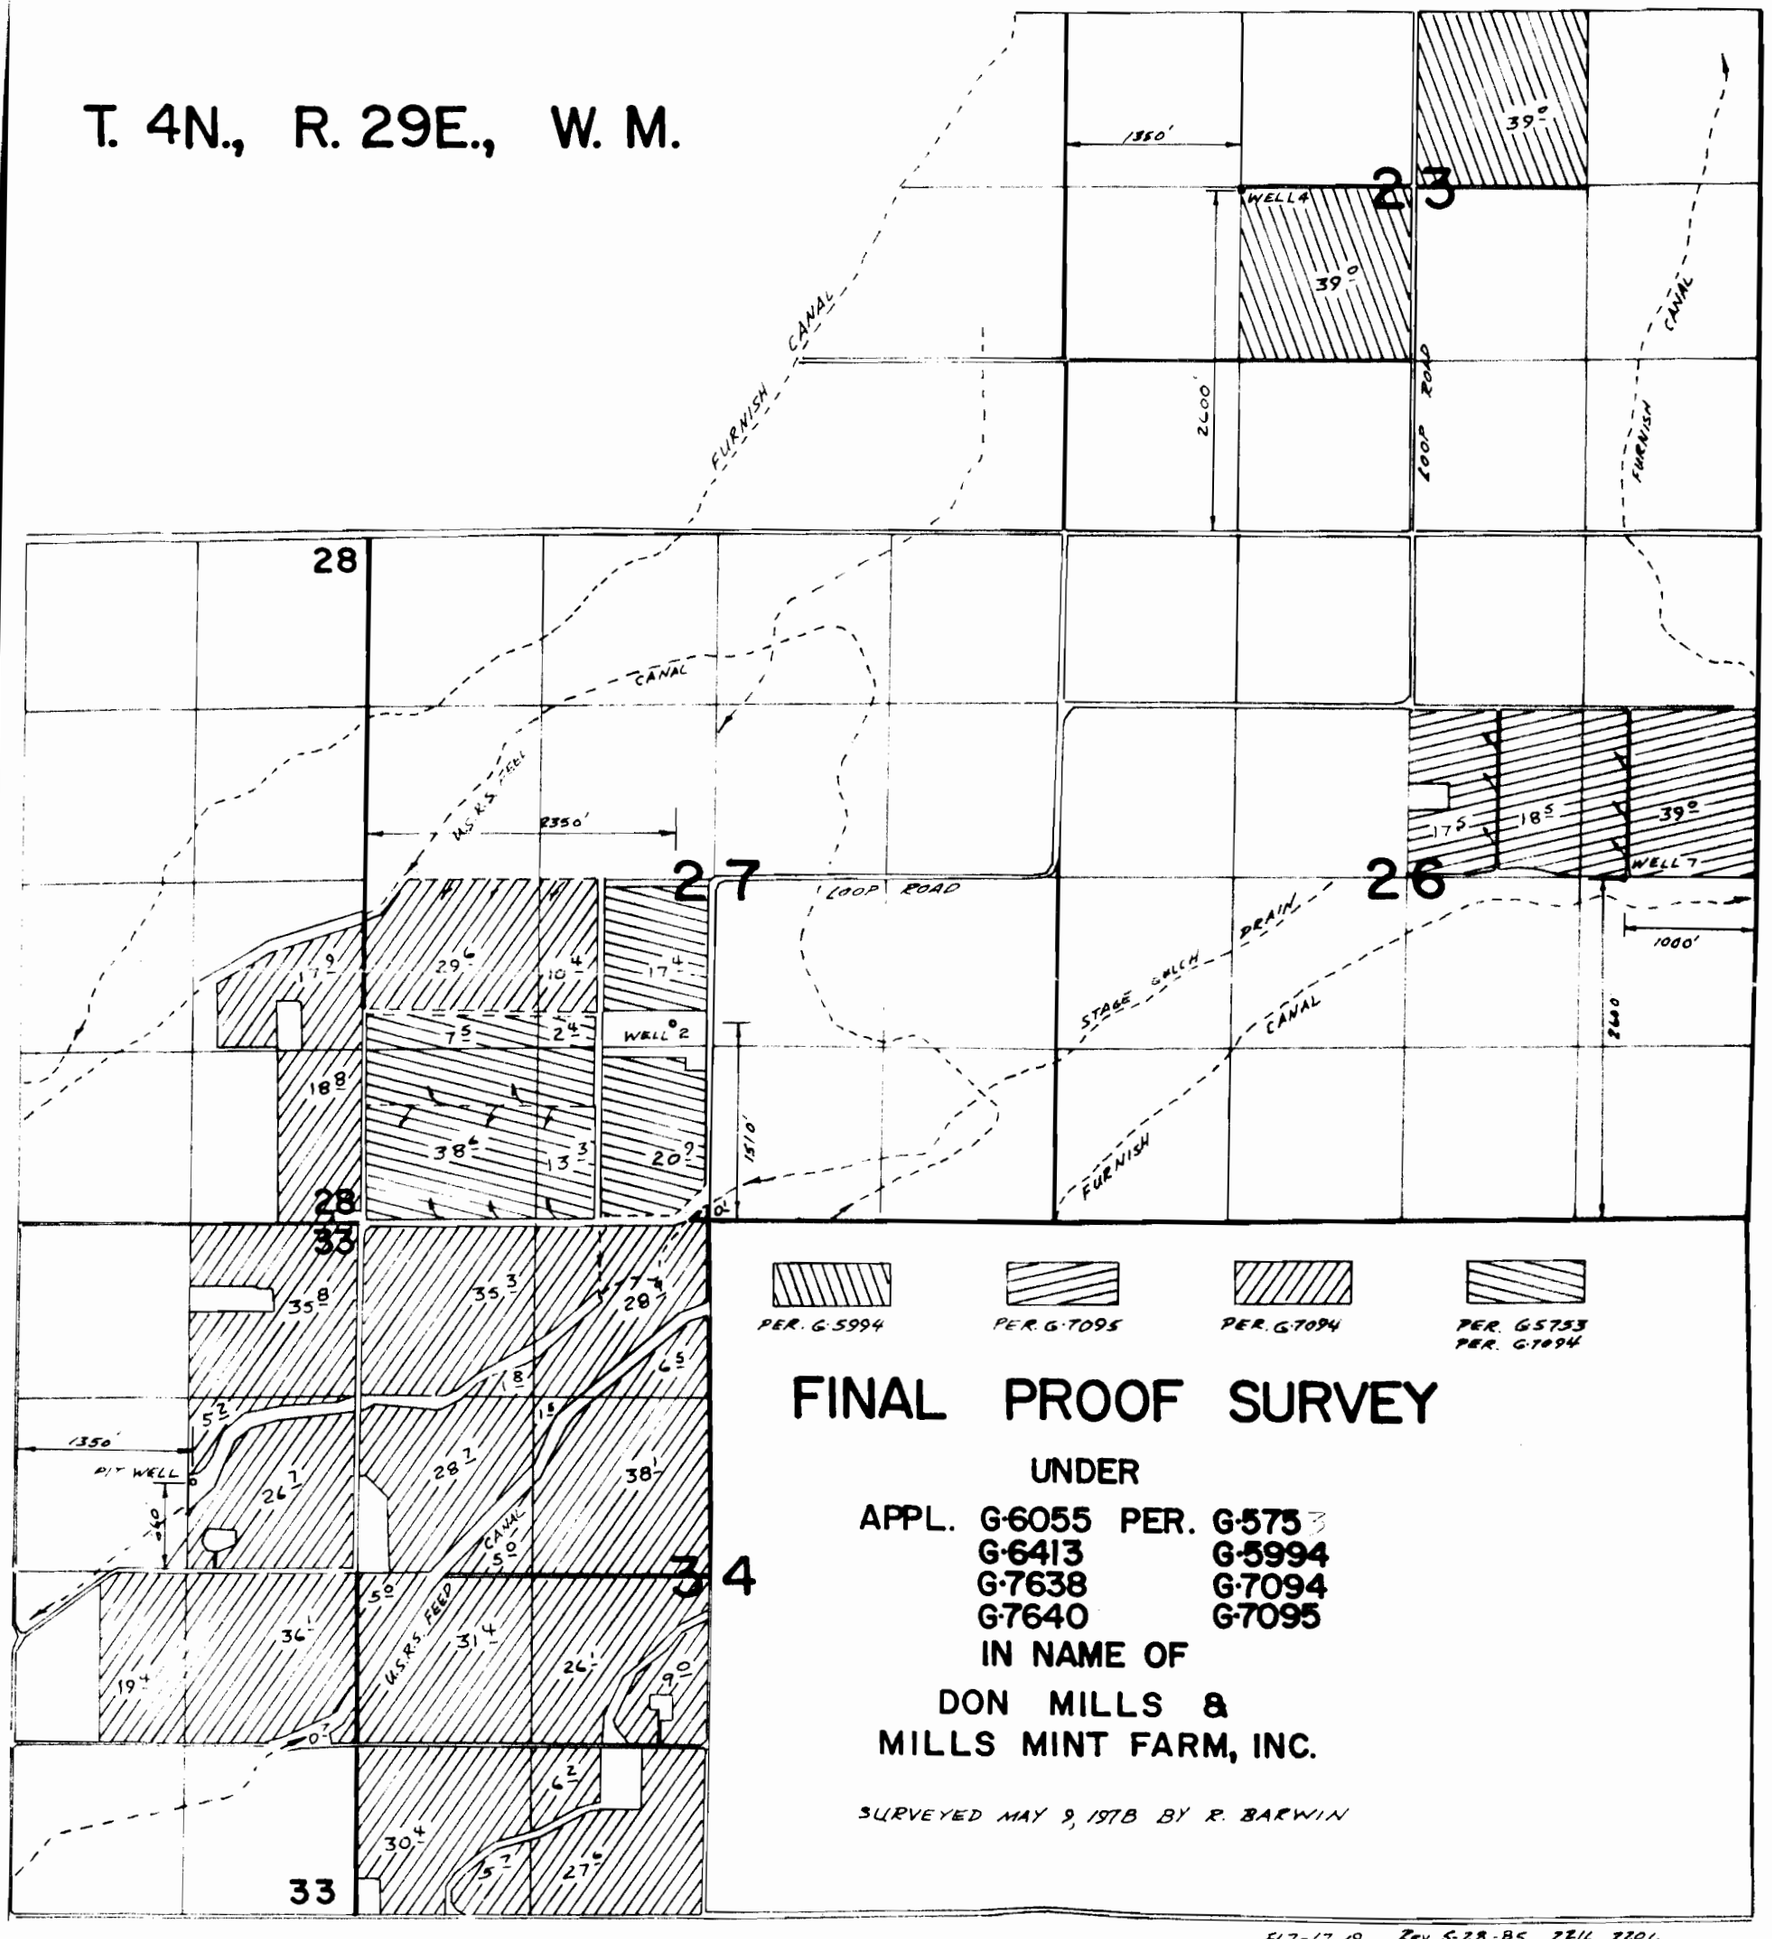

FINAL PROOF SURVEY

UNDER

APPL. G-6055 PER. G-5733
G-6413 G-5994
G-7638 G-7094
G-7640 G-7095

IN NAME OF

DON MILLS &
MILLS MINT FARM, INC.

SURVEYED MAY 9, 1978 BY R. BARWIN

FL 7-17, 19 Rev. 5-28-85 221L 220L