


5

T. 4N., R. 29E., W. M.

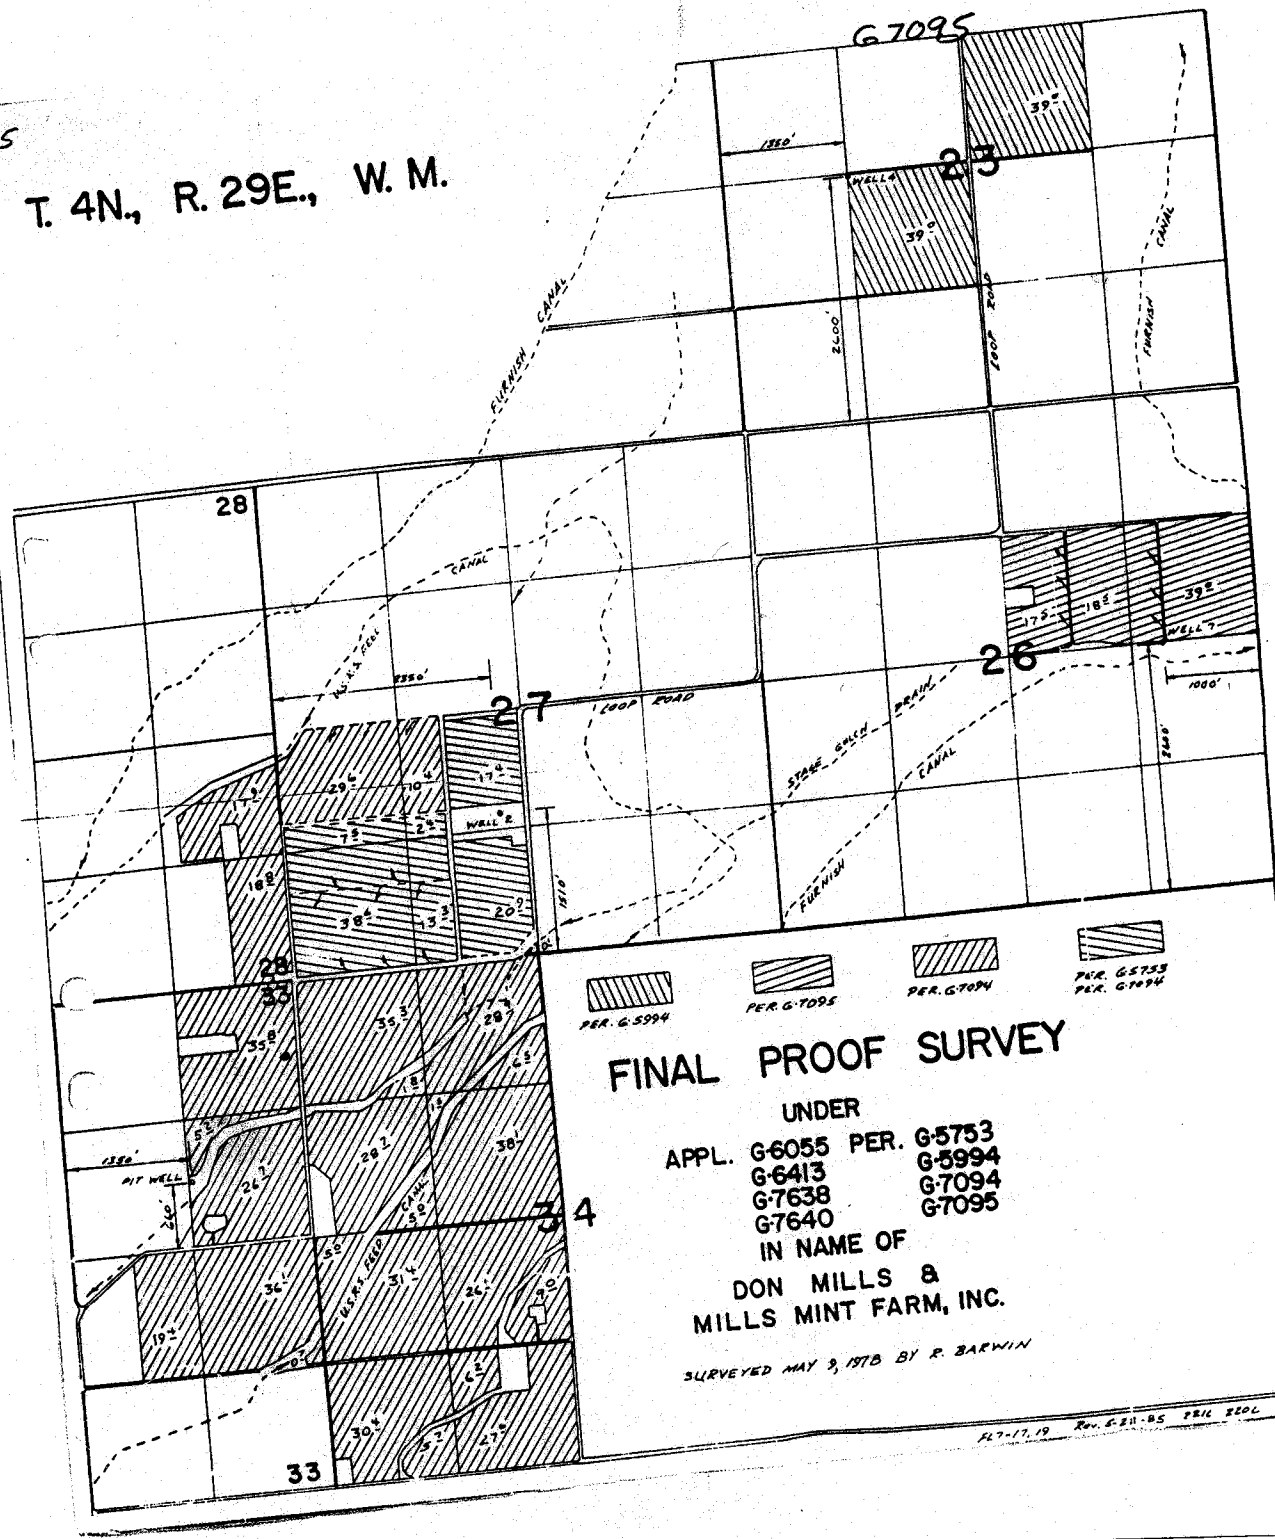

 PER. G-5994
 PER. G-7095
 PER. G-7094
 PER. G-5753

FINAL PROOF SURVEY

UNDER
 APPL. G-6055 PER. G-5753
 G-6413 G-5994
 G-7638 G-7094
 G-7640 G-7095

IN NAME OF
 DON MILLS &
 MILLS MINT FARM, INC.

SURVEYED MAY 9, 1978 BY R. BARWIN