


T. 6N. R. 35E. W. M.

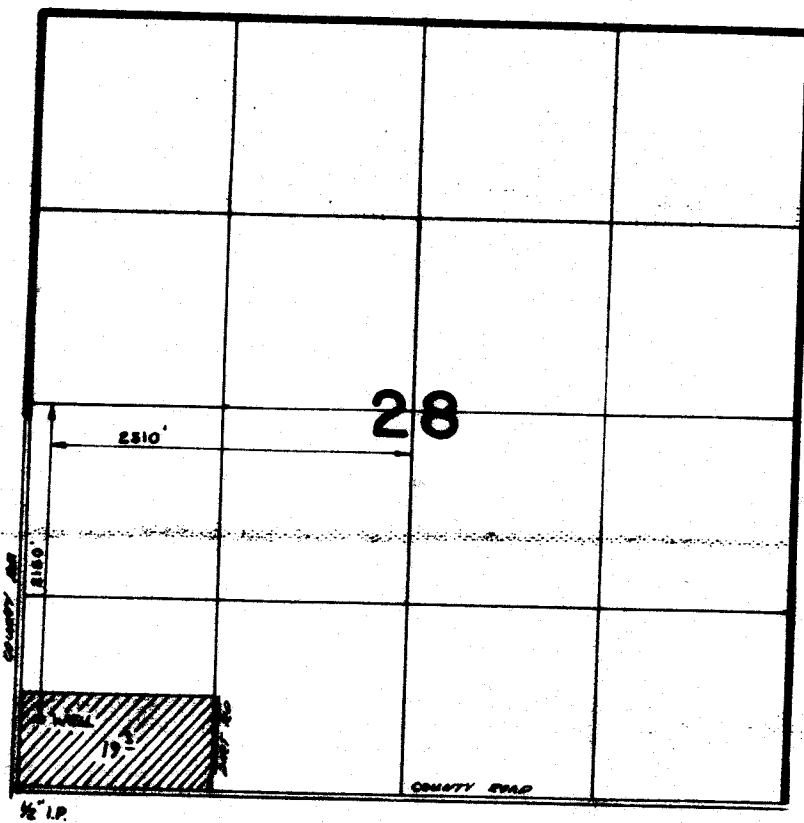

FINAL PROOF SURVEY
UNDER

Application No. **G-9133** Permit No. **G-8469**
IN NAME OF

GARY MOSS

Surveyed 10-17 1972, by H. Church