


G-9258

53489

WATER RESOURCES DEPT

T. 6N., R. 35E., W.M.

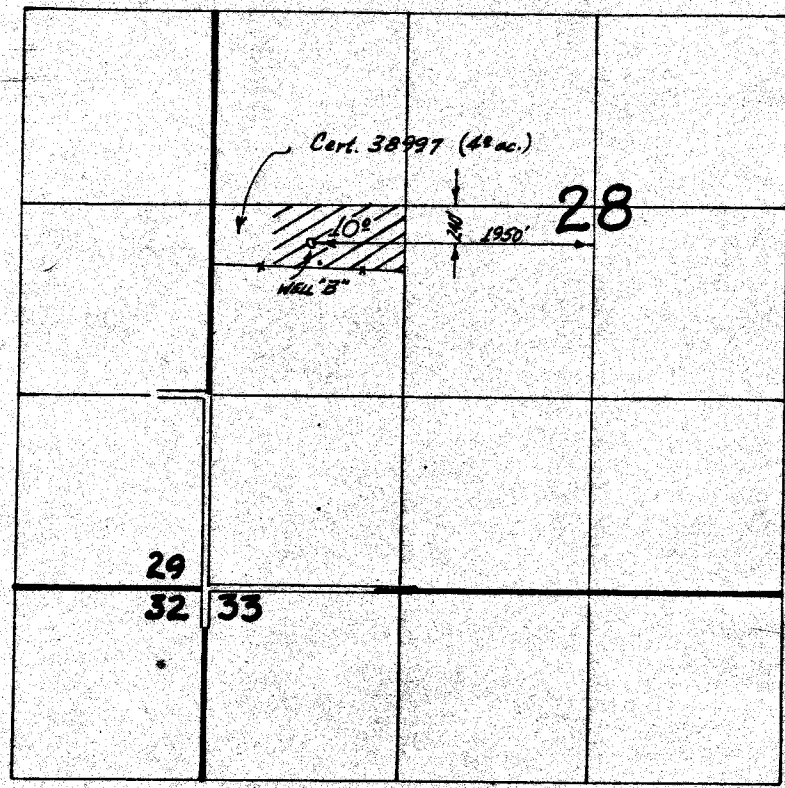

SCALE: 4" = 1 MILE

Application No. G-9441  
Permit No. G 9258

CLIFFORD & VIRGINIA TROUT