


T. 2S. R. 44E. W.M.

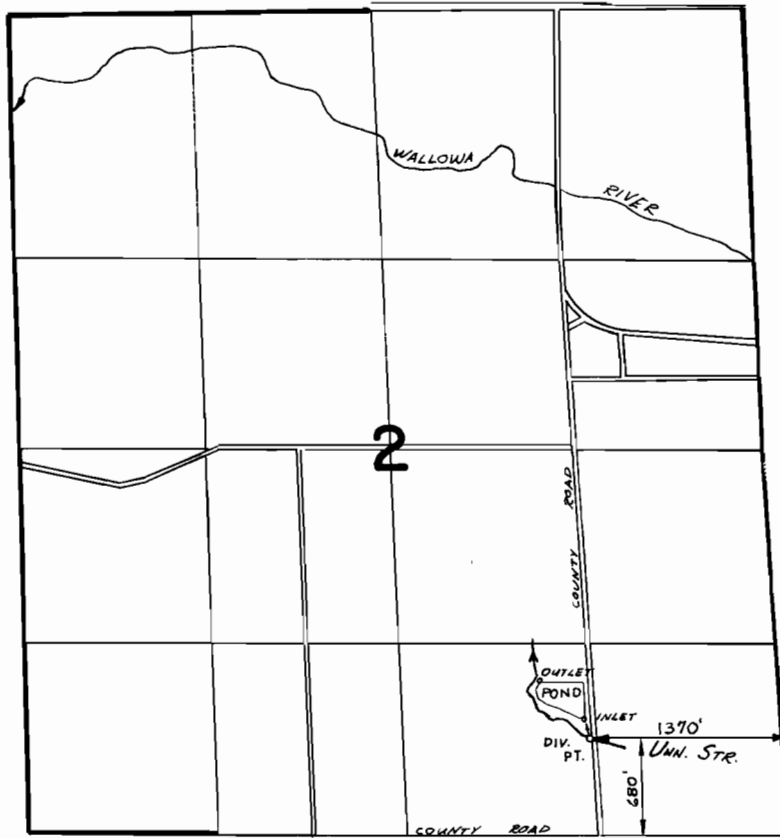

FINAL PROOF SURVEY
UNDER

54058 40482
Application No. R-54057 Permit No. R-6454
IN NAME OF

..... DR. LOWELL EUHUS

Surveyed 8-30 1978, by R. BARWIN.....