


T.2&3S. R. 45E. W. M.

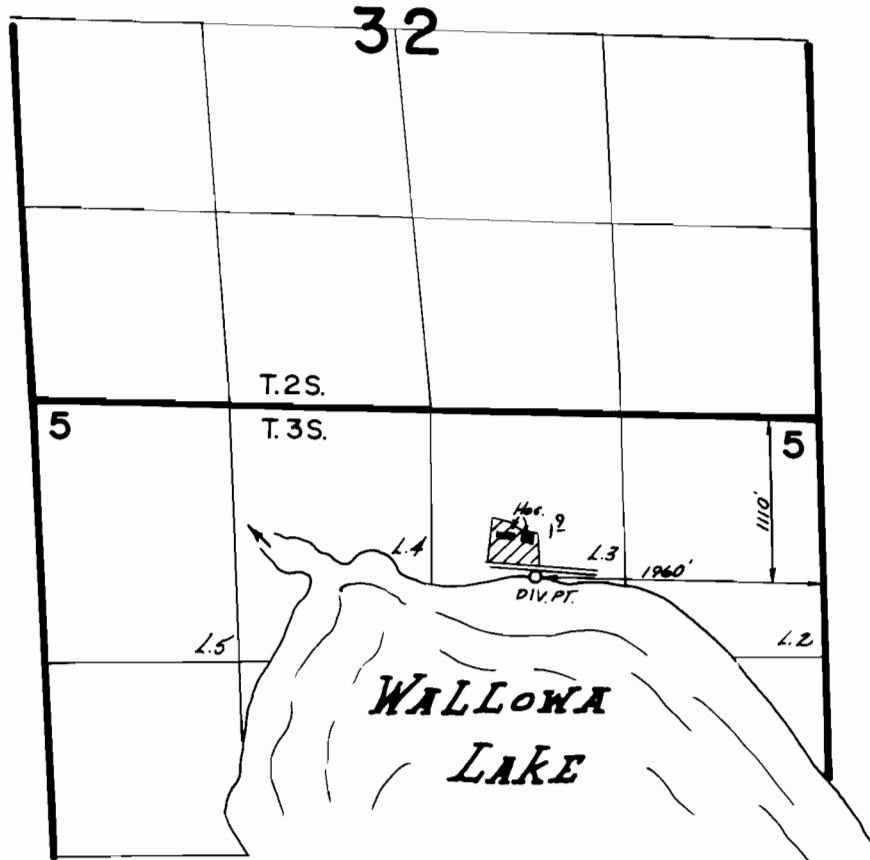

FINAL PROOF SURVEY
UNDER

Application No. 55341 Permit No. 41493
IN NAME OF

GEORGE J. JUSTICE & LEE ROBERTS

Surveyed 8-15 1978, by R. BARWIN