


T.1N., R.42E., W.M.

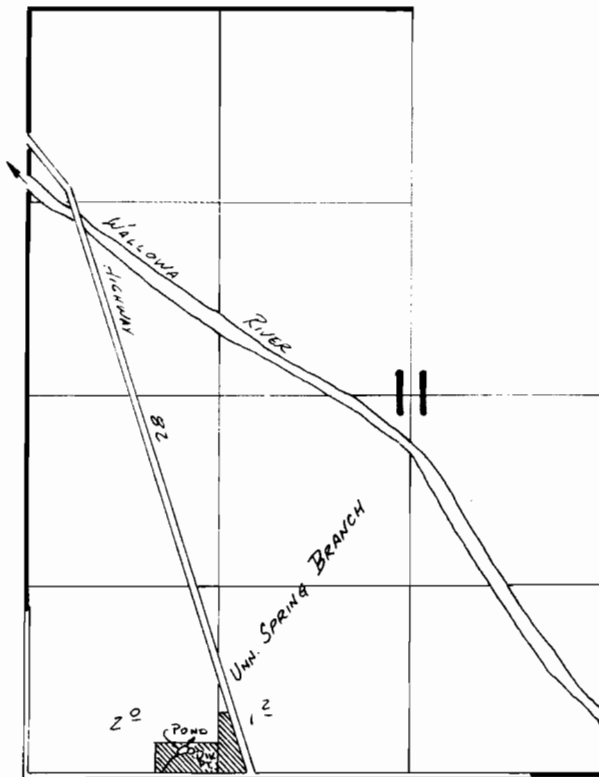

DAM Loc. 170' N. & 1130' E. FROM
SW COR. SEC. 11

FINAL PROOF SURVEY

UNDER

55096

41454

Application No. 50415 Permit No. 38048...

IN NAME OF

...ROBERT E. & AGNES T. JOSI.....

Surveyed 8-29..... 1978., by R.F. BARNUM.....