



T. 2S. R. 45E. W.M.

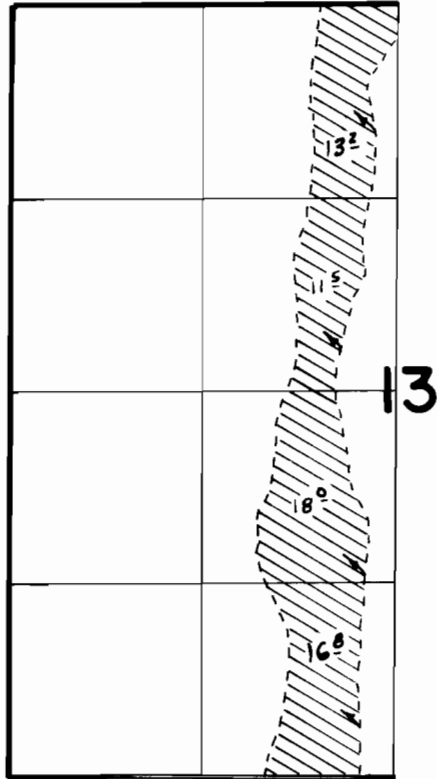

T 3S. R. 45E. W.M.

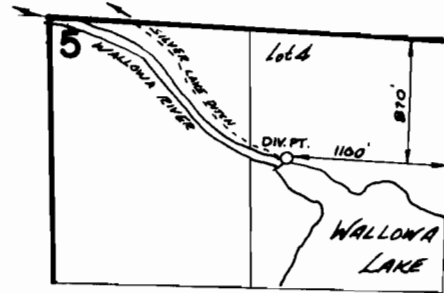

**FINAL PROOF SURVEY**  
UNDER

Application No. 51276 Permit No. 38722  
IN NAME OF

.....DONALD L. HOUGH.....

Surveyed 8-22 197B., by R. BARWIN.....