
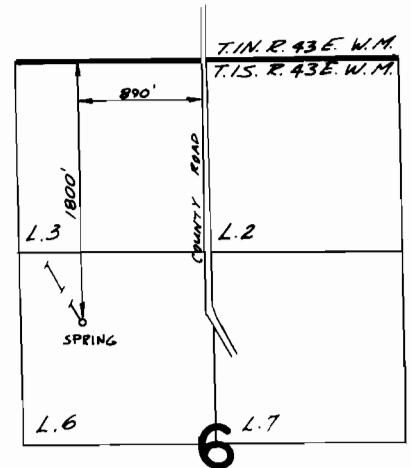


T. 1N., R. 42 & 43 E. W. M.

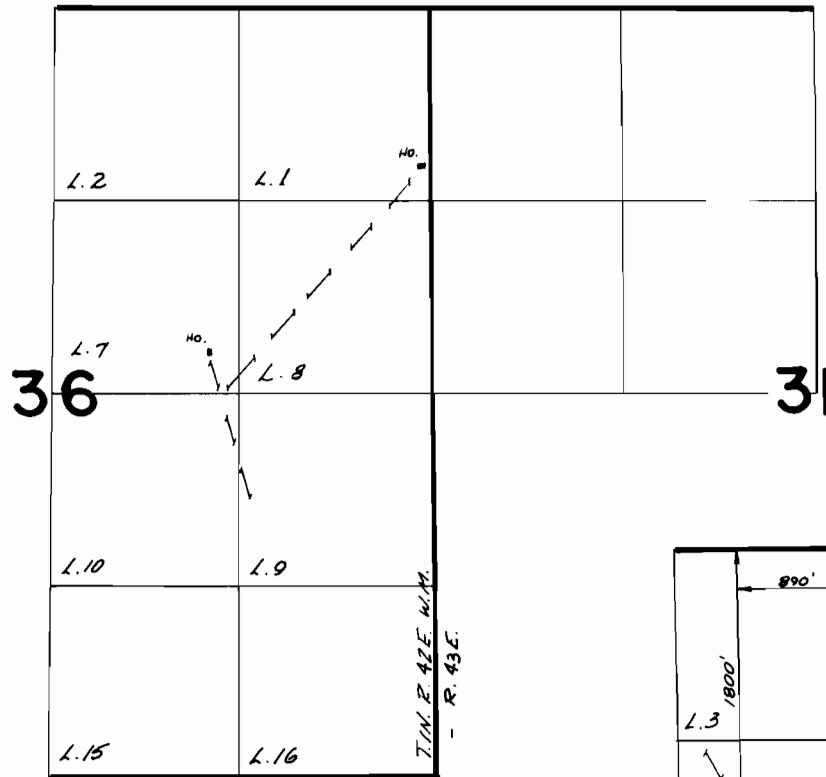

FINAL PROOF SURVEY UNDER

Application No. 52895 Permit No. 39918
IN NAME OF

ELVYN P. REEL & C. C. WYCKOFF

Surveyed 8-22 1978, by P. BARNUM