


# T. 2S. R. 45E. W.M.

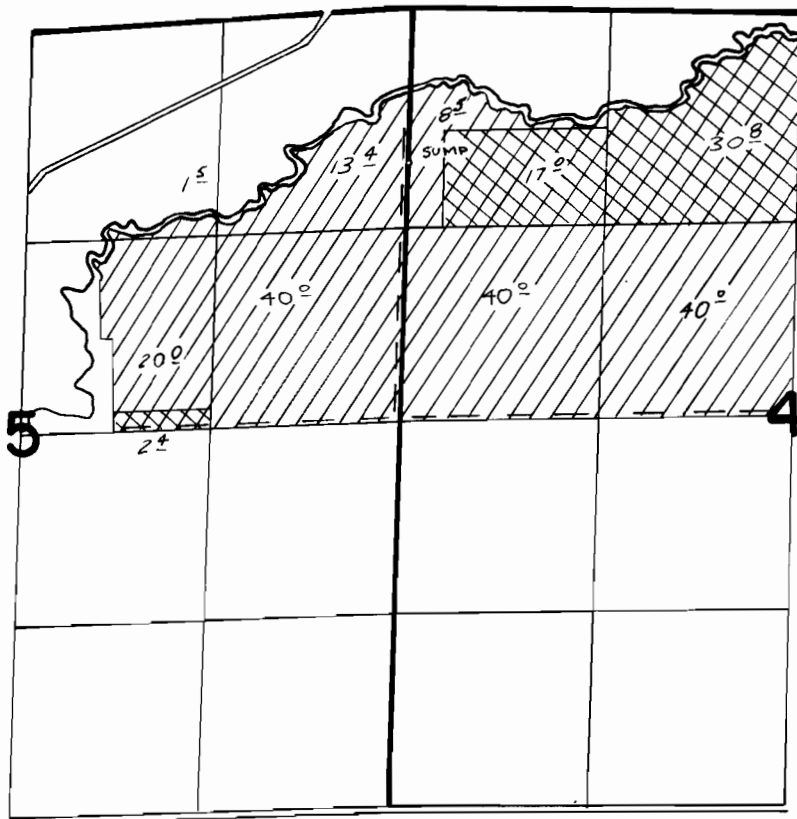

PUMP LOCATED 1060'S & 10E. FROM NE COR SEC 5



Prim



Suppl

## FINAL PROOF SURVEY UNDER

Application No. G-7943 Permit No. G-7327  
IN NAME OF

PAUL J. YOST

Surveyed 8-22..... 1978., by R. BARWIN.....