


T. 5 S., R. 7 W., WM.

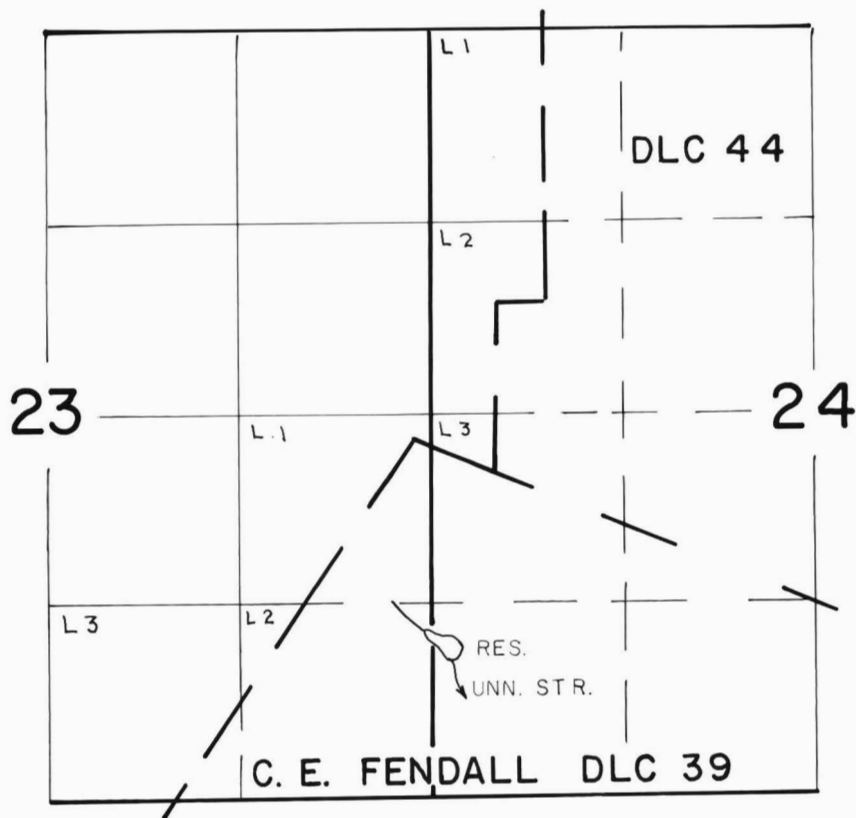

DIV. PT. LOC. 940' N. & 110' E. OF SW. COR. SEC. 24

FINAL PROOF SURVEY UNDER

Application No. **R60539** **60540** Permit No. **R8499** **47020**
IN NAME OF

WALTER G. MENDENHALL

Surveyed **NOV. 8**, 19**84**, by **P. PAGTER**