


T. 5 S., R. 7 W., WM.

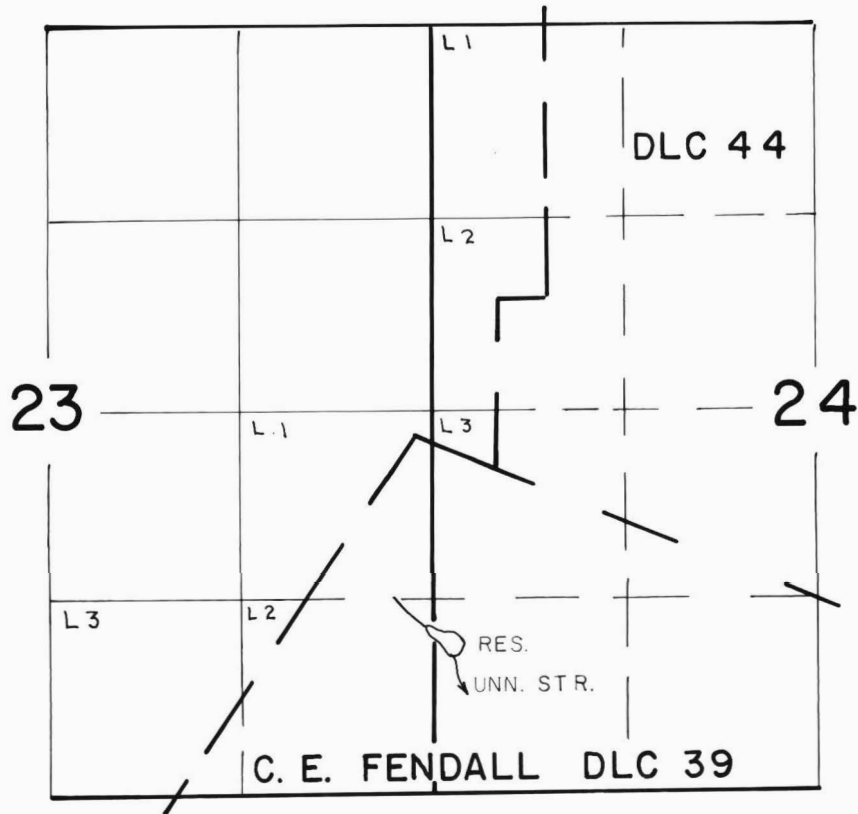

DIV. PT. LOC. 940' N. & 110' E. OF SW. COR. SEC. 24

SCALE
1" = 1320'

FINAL PROOF SURVEY UNDER

Application No. R60539 60540 Permit No. R8499 47020
IN NAME OF

WALTER G. MENDENHALL

Surveyed NOV. 8 1984, by P. PAGTER