


T.8S. R.2W. W.M.

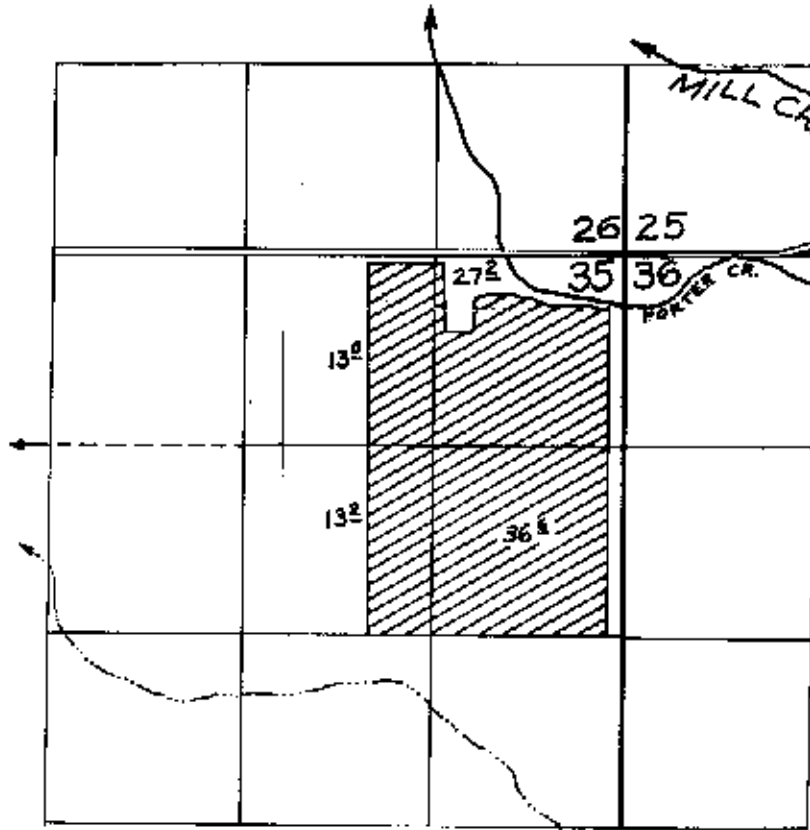

FINAL PROOF SURVEY

UNDER

Application No. E-81 Permit No. E-82

IN NAME OF

L. E. WILLIAMS

Surveyed JUL 3, 1970, by S. APPLGATE