


T.29S. R.11W. W.M.

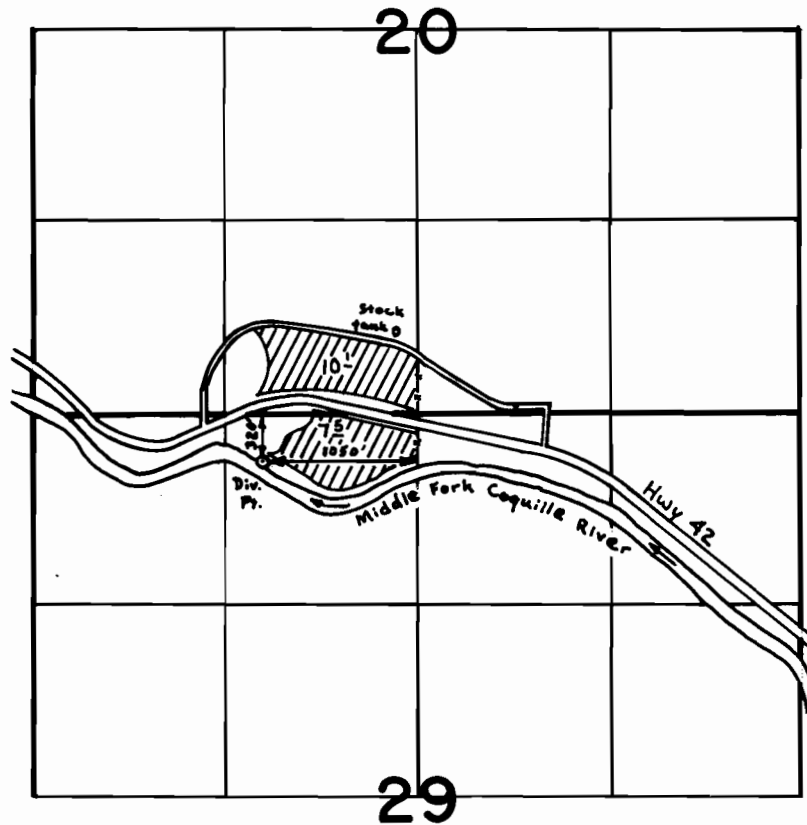

SCALE: 4" = 1mi.

**FINAL PROOF SURVEY  
UNDER**

Application No. 50860 Permit No. 38400  
IN NAME OF

EARL A. FIELDS

Surveyed May 17 1978, by D. Sparks