


T.23S. R.12W. W.M.

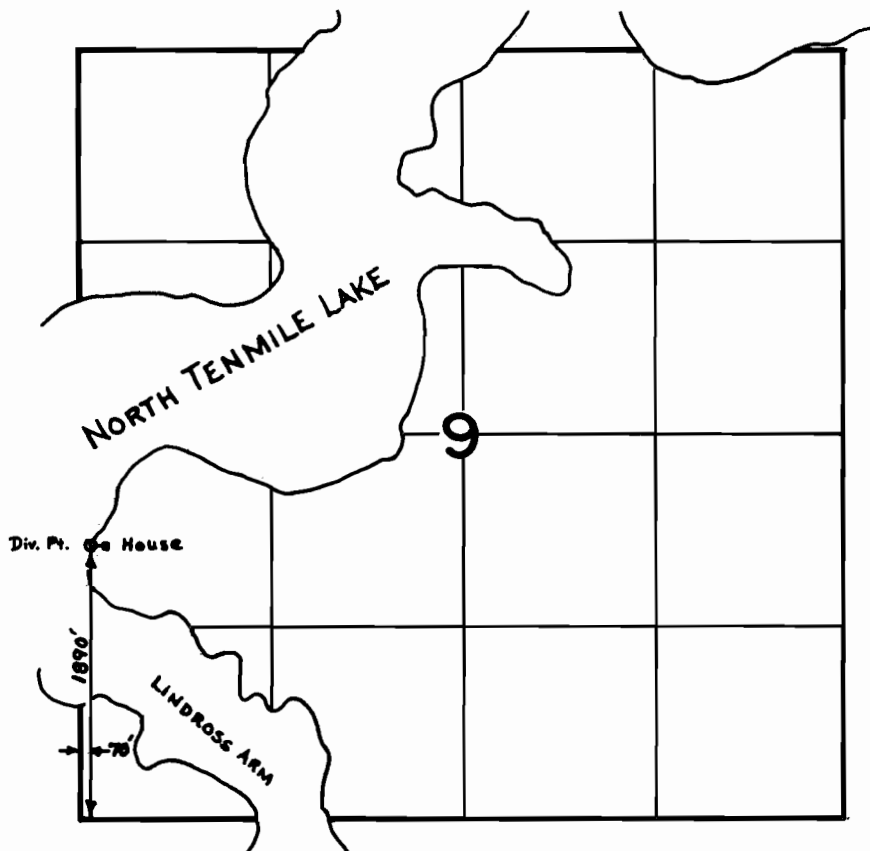

SCALE: 4" = 1 mile

FINAL PROOF SURVEY
UNDER

Application No. 51558 Permit No. 38898
IN NAME OF

VIRGINIA O'BANION

Surveyed Nov. 14, 1978, by S. Donaldson