


T.26 S. R.12 W. W.M.

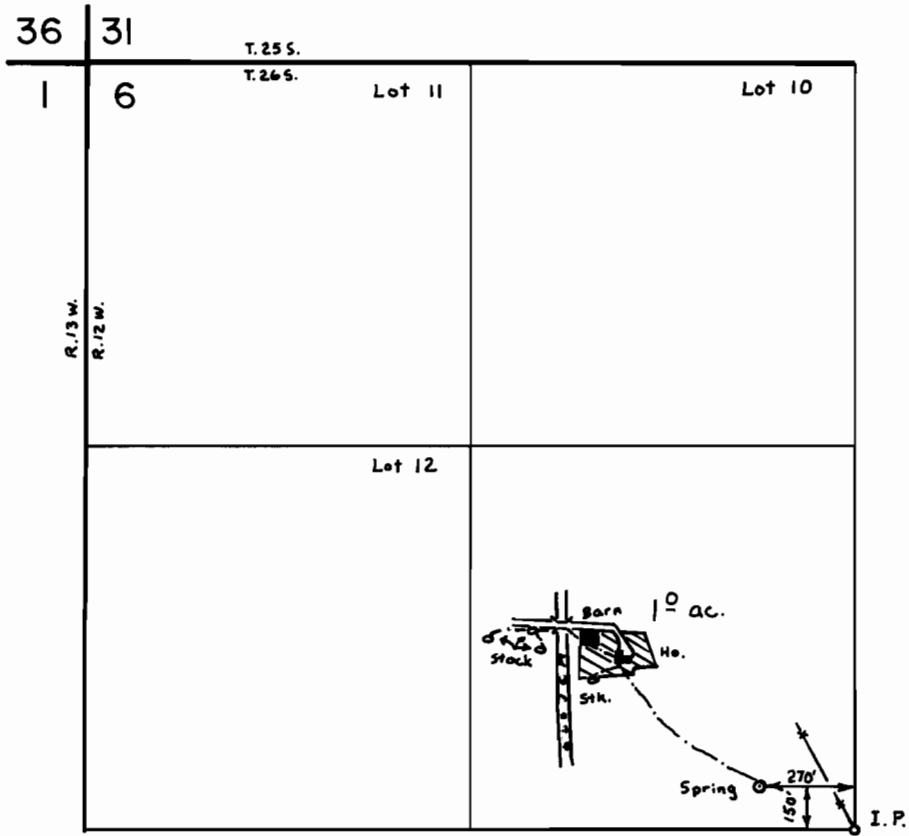

SCALE : 1" = 660'

FINAL PROOF SURVEY UNDER

Application No. 55537 Permit No. 42393

IN NAME OF

DELBERT E. ATKINS

Surveyed March 9 1978, by D. Sparks