


T.29 S. R.12W. W.M.

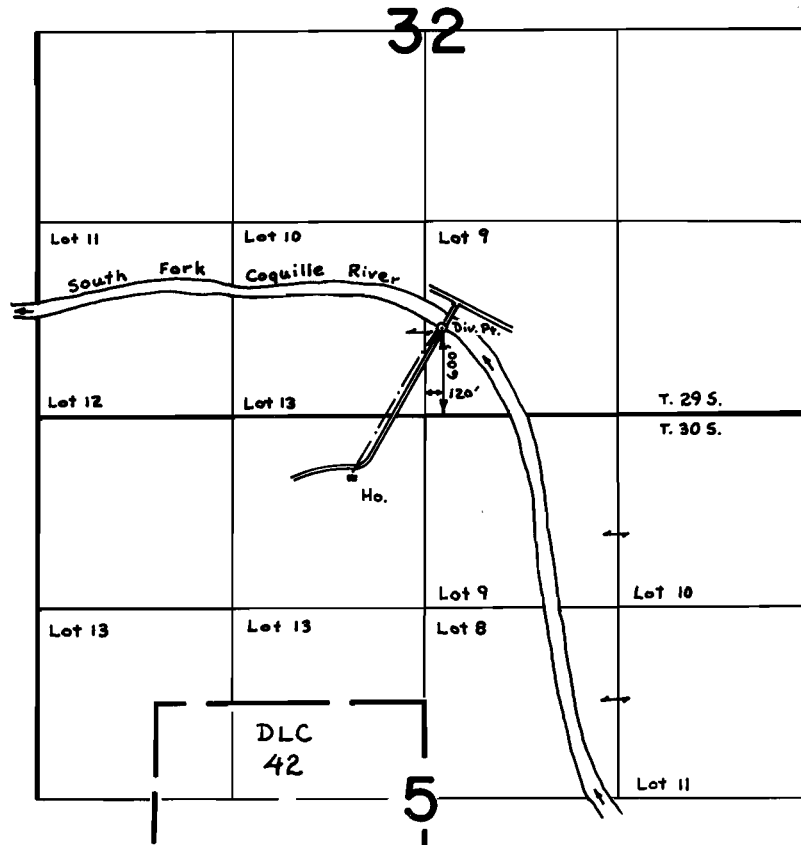

SCALE: 4" = 1 mi.

FINAL PROOF SURVEY
UNDER

Application No. 55367 Permit No. 42562
IN NAME OF

ARCHIE ALAN TRAIN

Surveyed May 18 1978, by D. Sparks