


T.21S. R.5W. W.M.

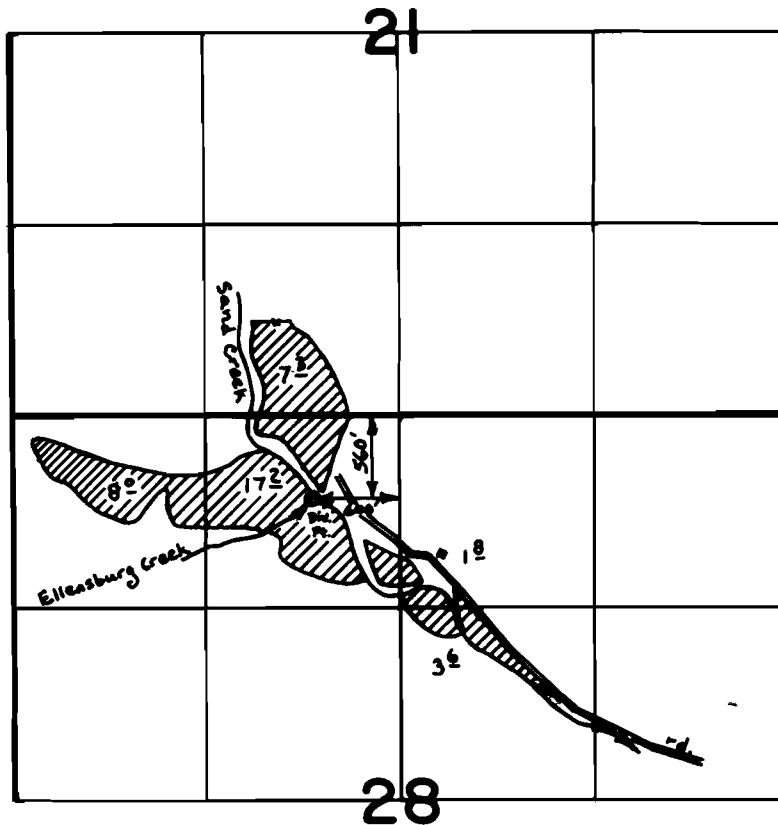

SCALE: 4" = 1 mile

FINAL PROOF SURVEY
UNDER

Application No. 49720 Permit No. 37272
IN NAME OF

SAND CREEK ESTATES

Surveyed Oct. 1, 1979, by S. Donaldson