


T.22S.,R.12W.,W.M. .
SEC. 31

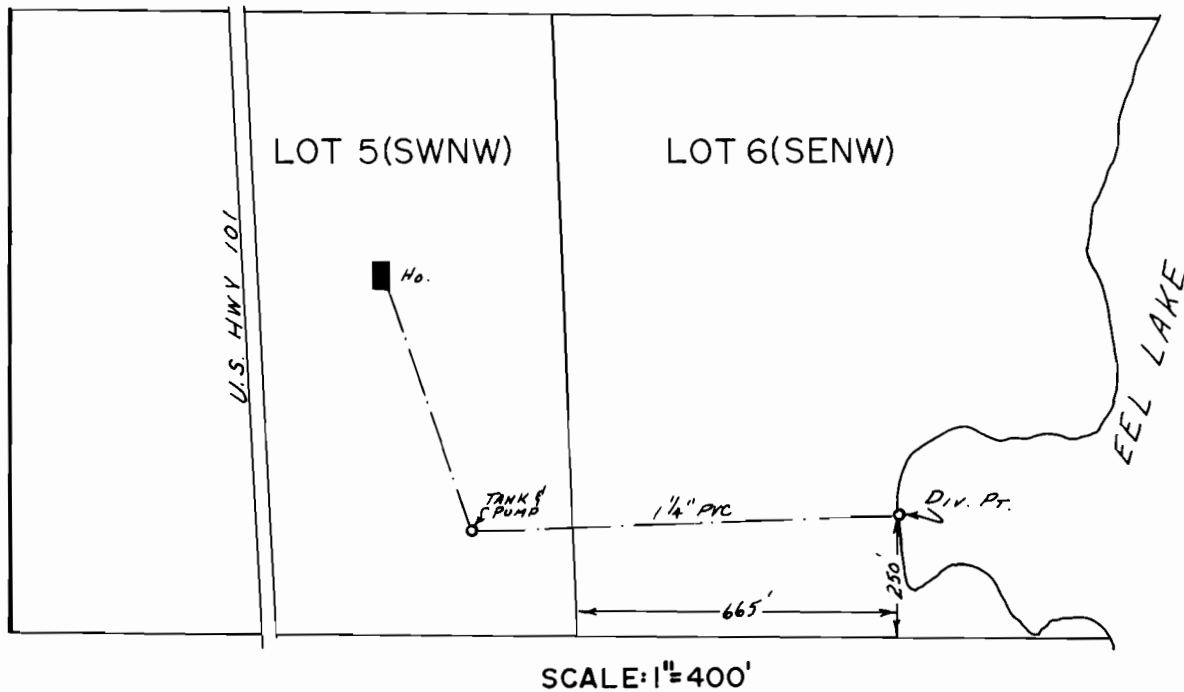

FINAL PROOF SURVEY
UNDER

Application No. 52687... Permit No. 37750.....
IN NAME OF

.....E.C. DAILY.....

Surveyed JUNE 3, 1980, by J.S. DONALDSON