


P-44273
C-53531

4

T. 13 S., R. 29 E., WM

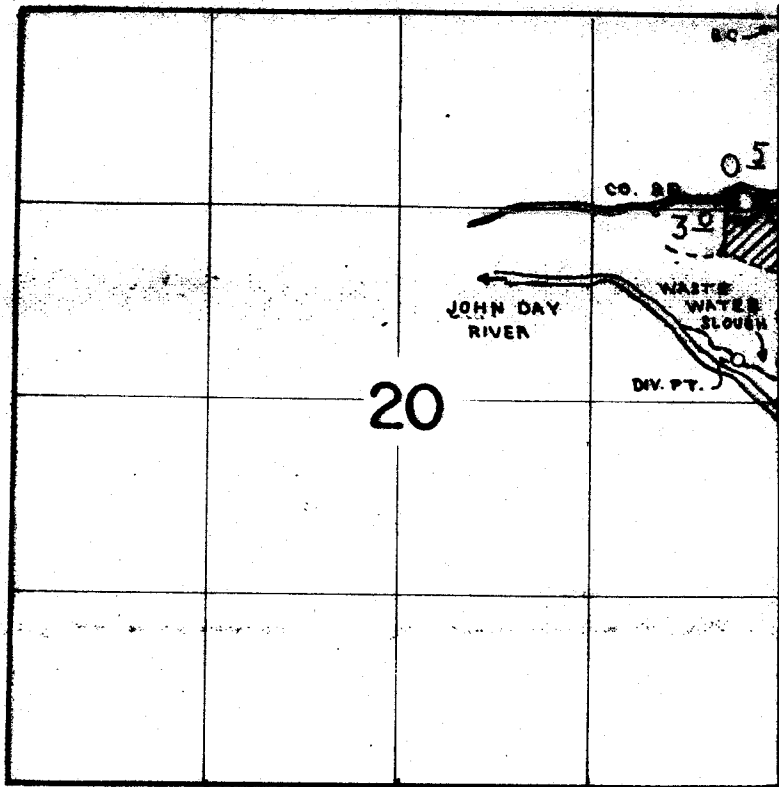

DIV. PT. LOC. 2350' S. & 270' W OF NE COR. SEC. 20

FINAL PROOF SURVEY
UNDER

Application No. 58719 Permit No. 44273
IN NAME OF

ELMER JOHNSON

Surveyed AUG 10 1984, by P. PAGTER