


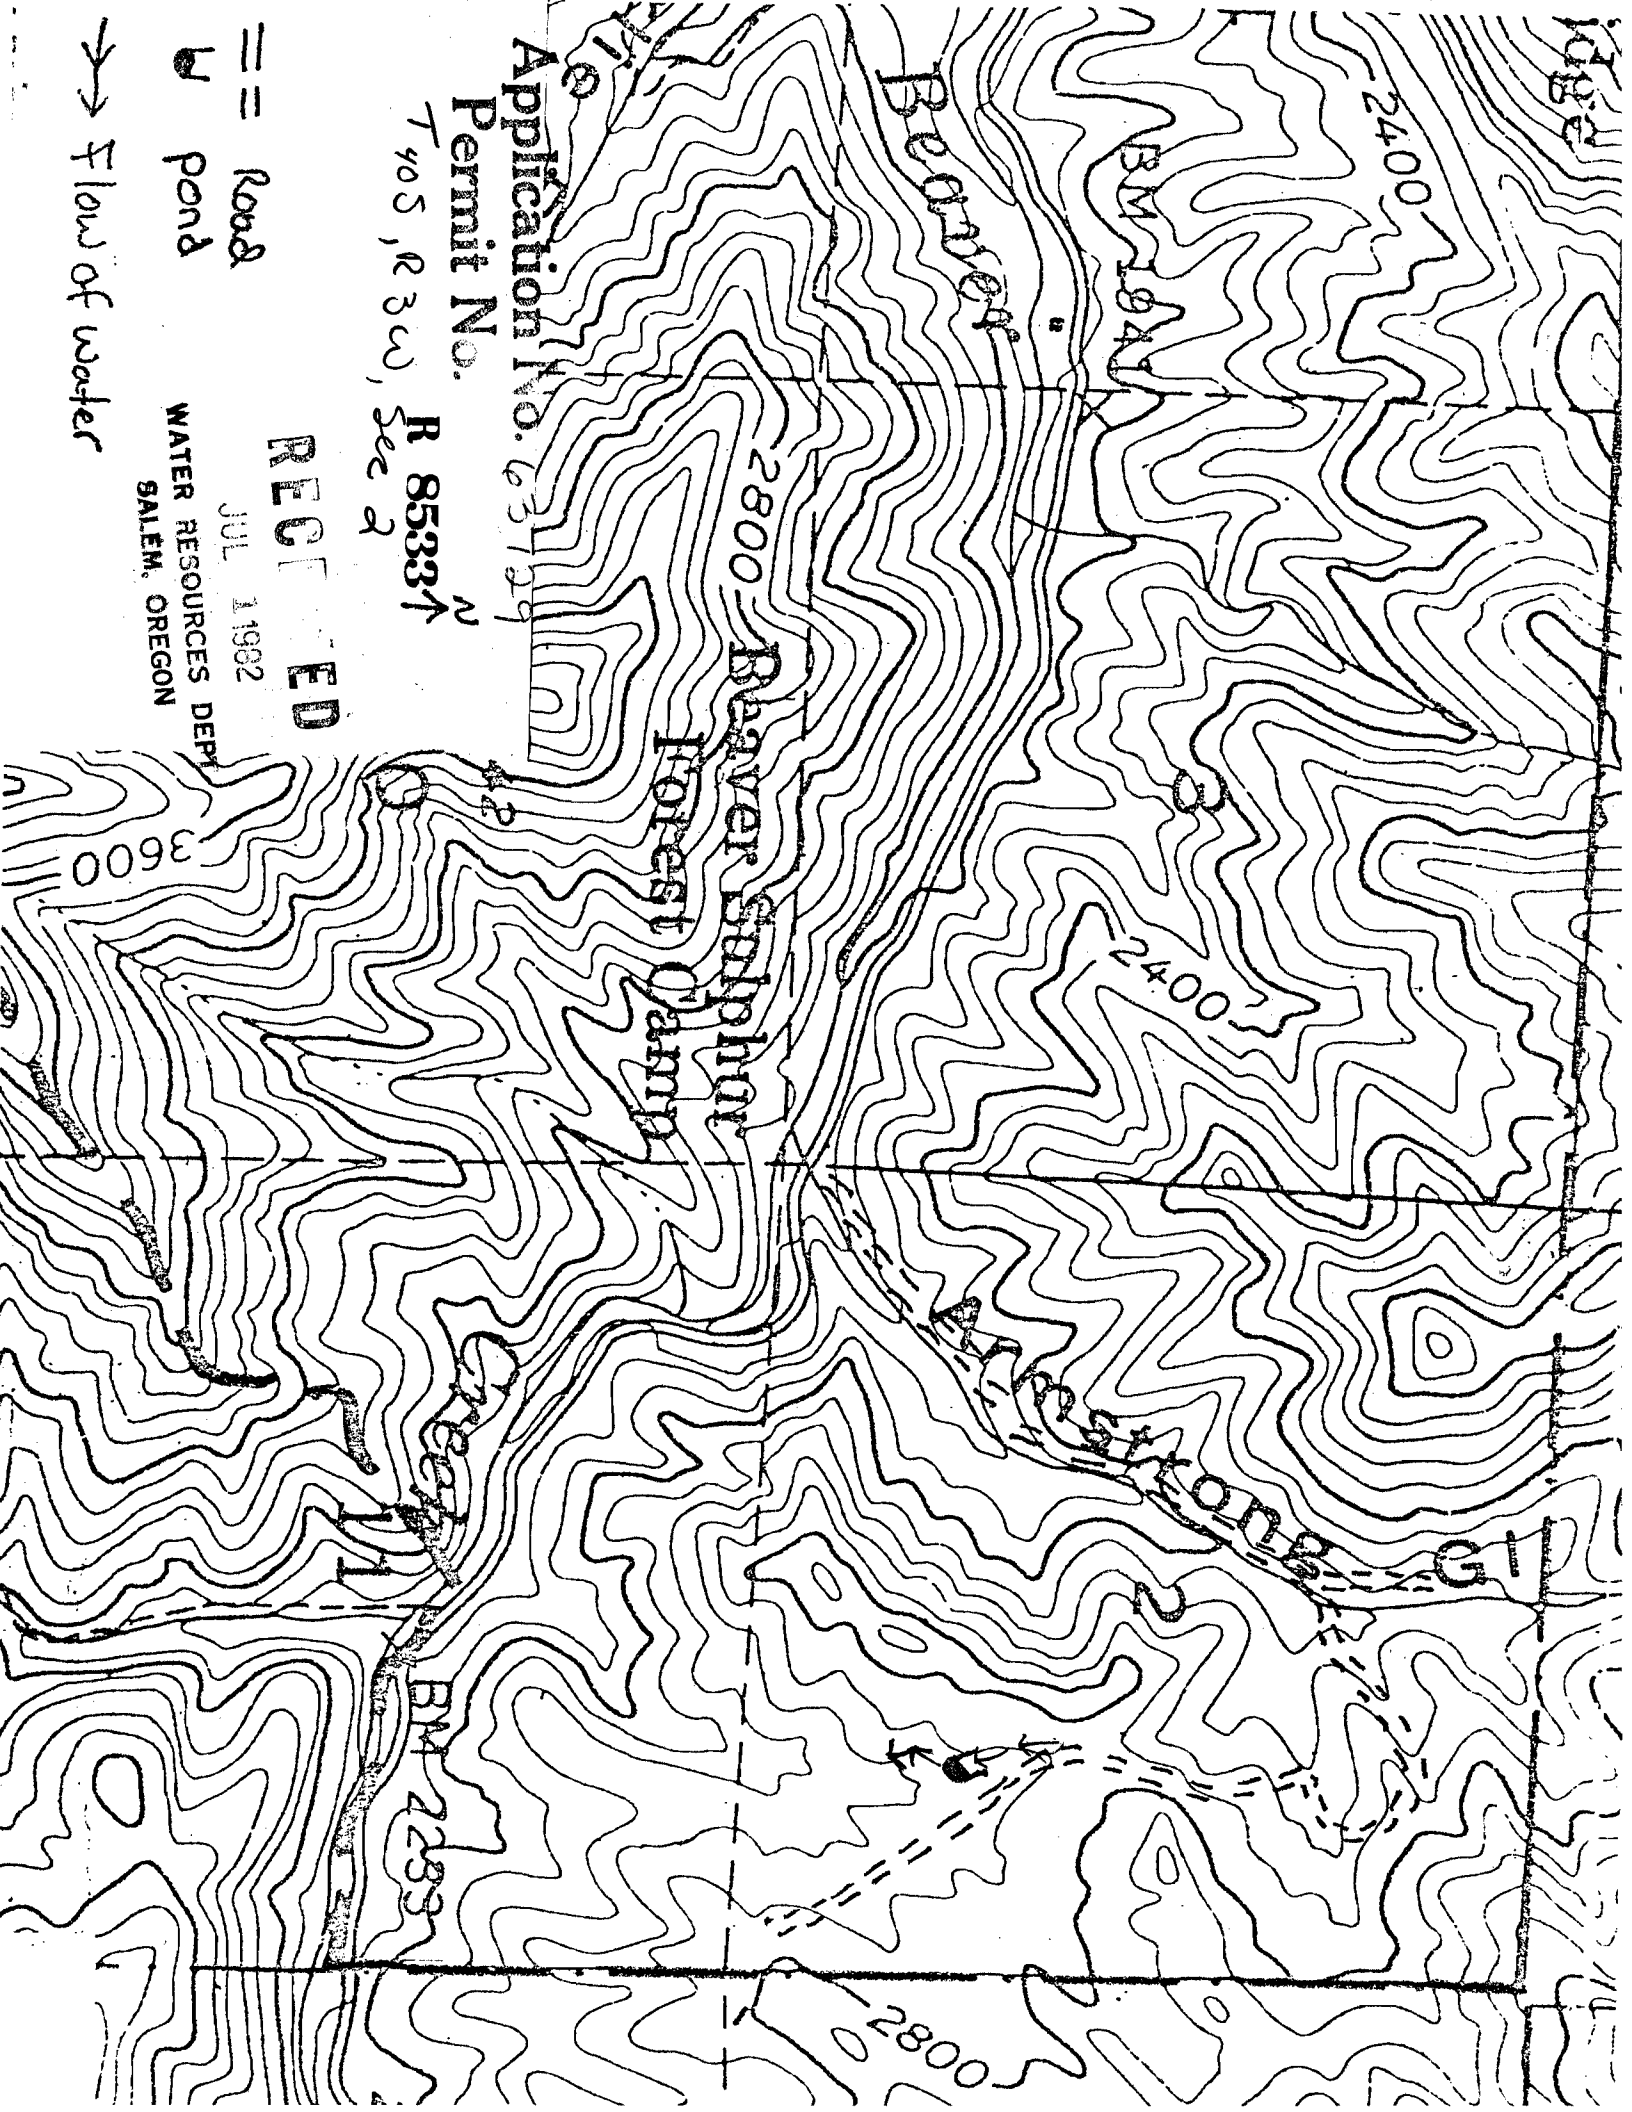

Application No. 63129

Permit No. R 8533

T 405, R 30, Sec 2

RECEIVED

JUL 1 1962

WATER RESOURCES DEPT
SALEM, OREGON

== Road
W pond

→ Flow of water