


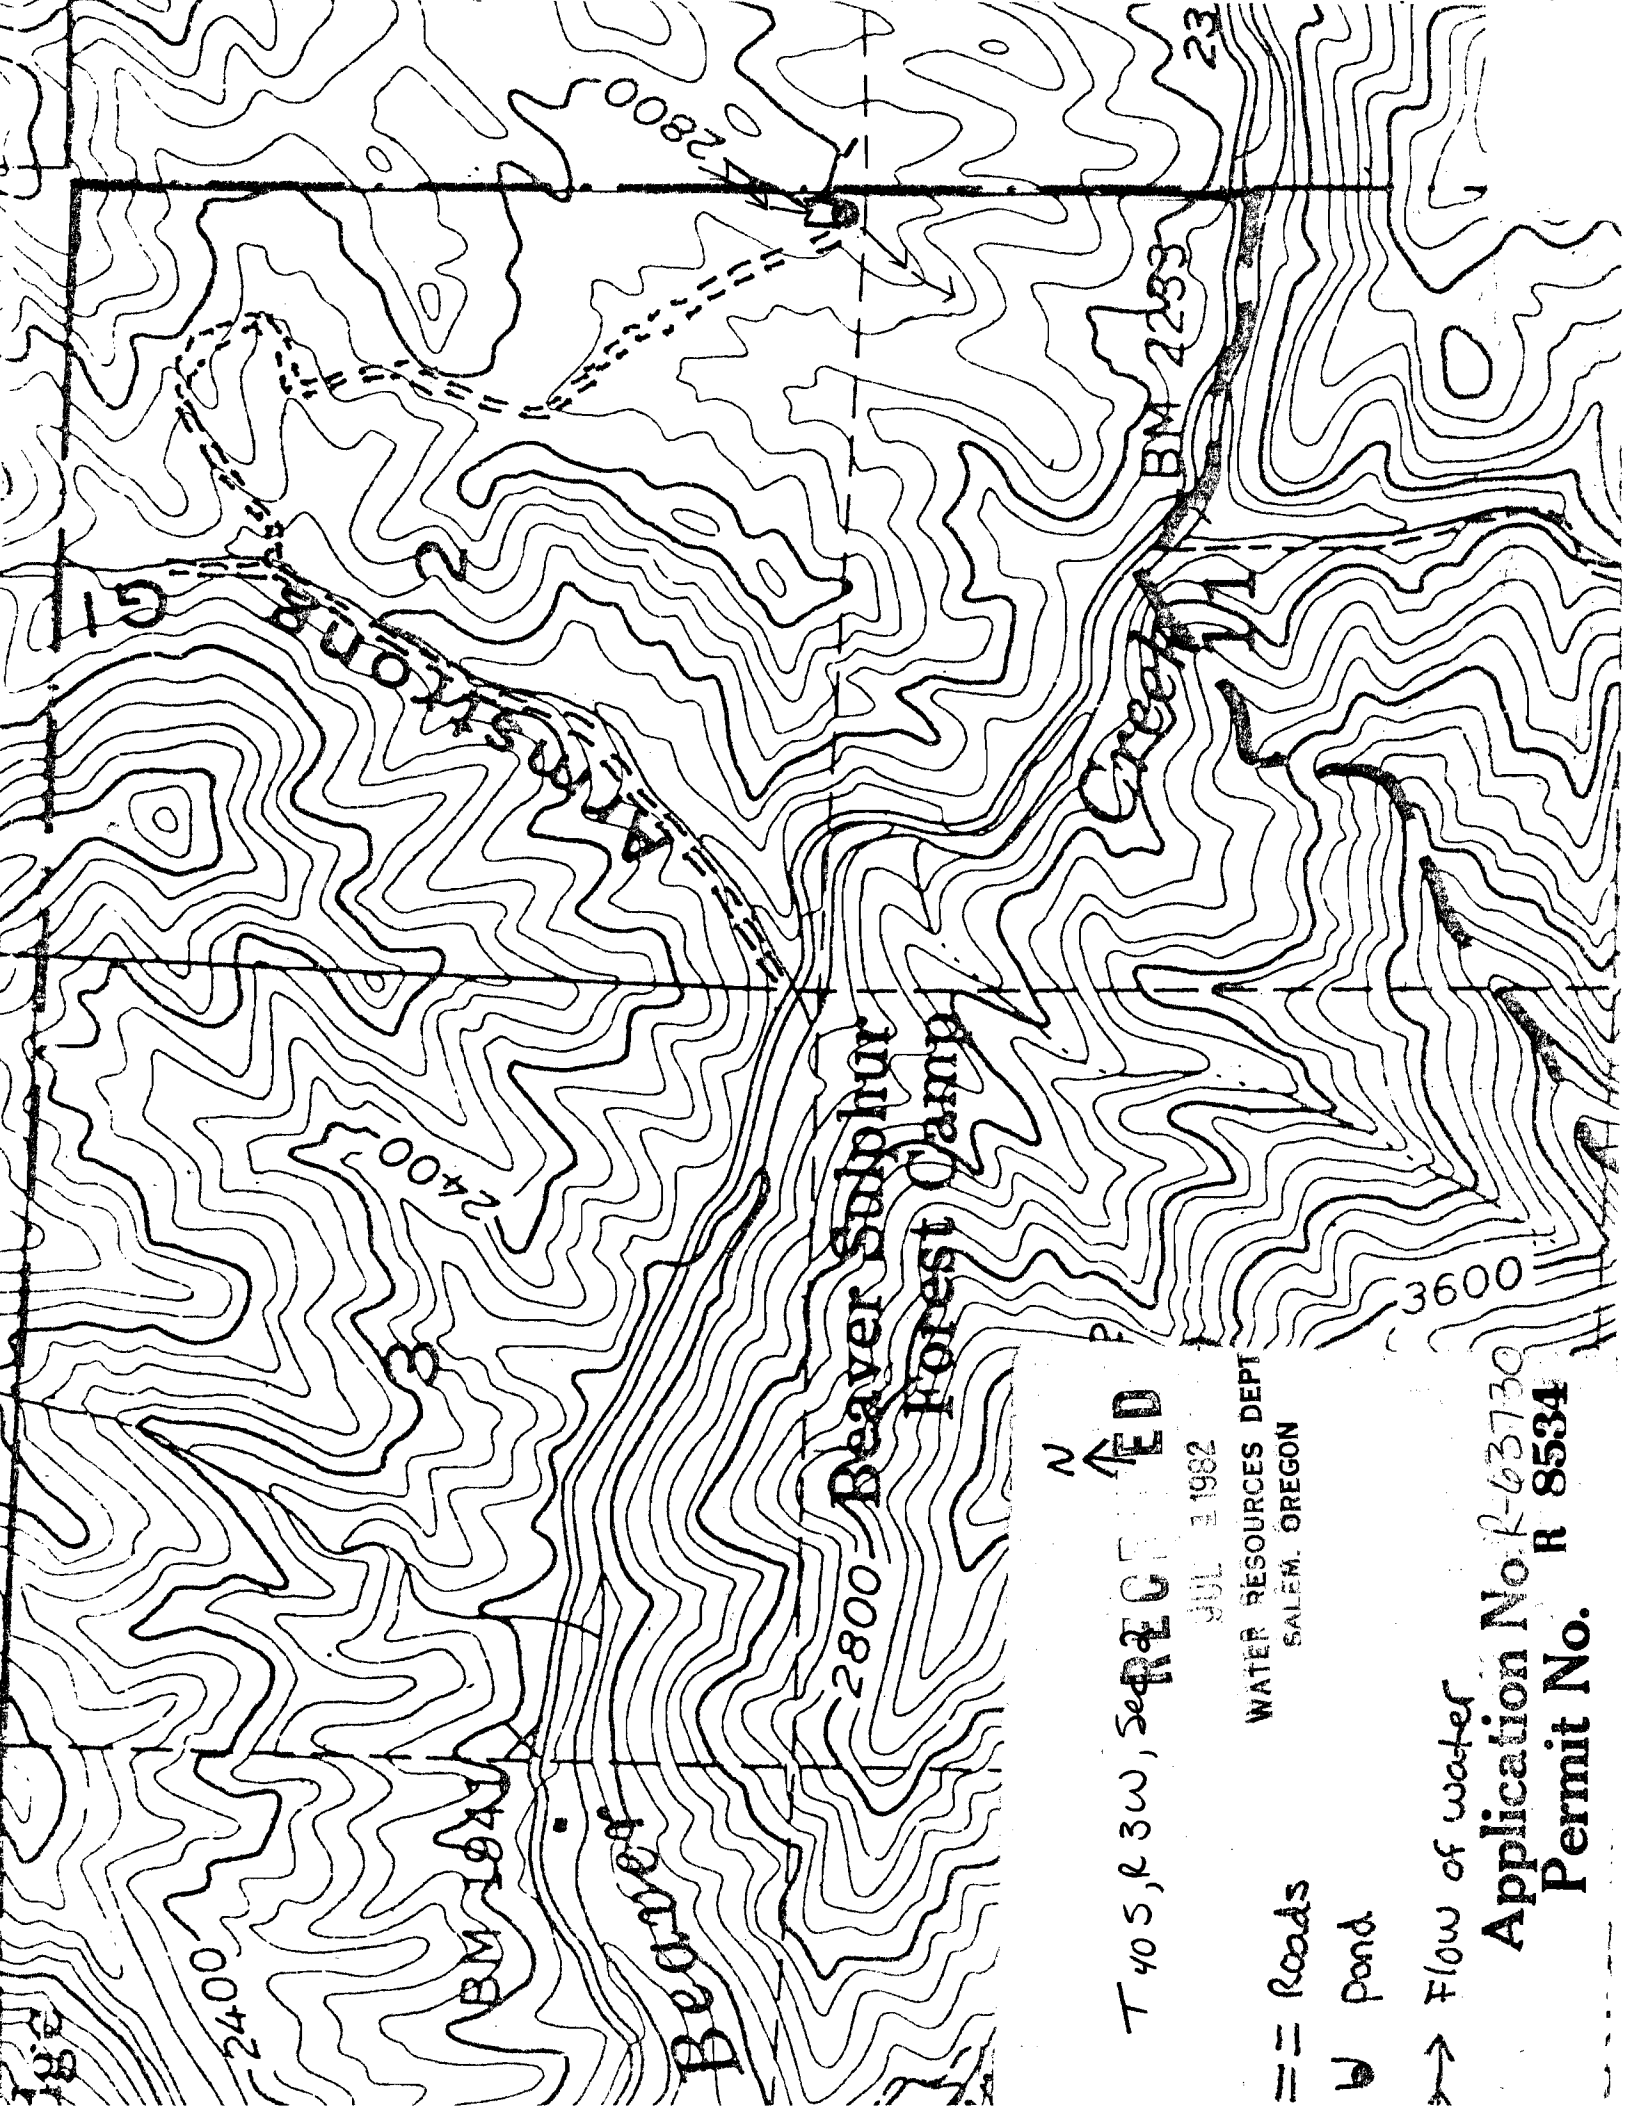

T 40 S, R 3 W, S 2 E

JUL 1 1982

WATER RESOURCES DEPT
SALEM, OREGON

== Roads

W Pond

→ Flow of water

Application No. R-63730
Permit No. R 8534