

RECEIVED ⁴⁶


AUG 3 1981

WATER RESOURCES DEPT
SALEM, OREGON

T.38S.R.3W.V.M.

Application No. 62054

Permit No. 45952

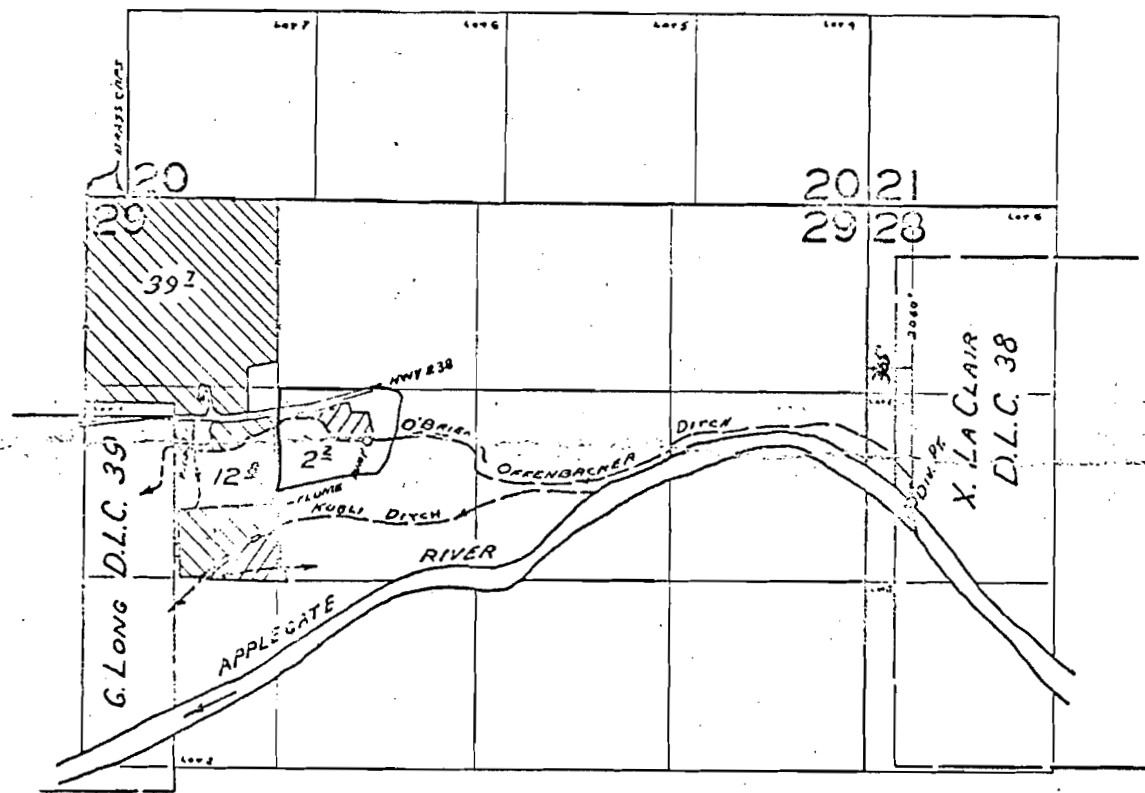

-  SAMPLE
-  SCHULTZ Mark Settle

Note: Div. Pt. location taken from Application map

FINAL PROOF SURVEY
UNDER

Map to accompany application of Mark G. Settle to appropriate water from Applegate Lake Reservoir in amount of 4 acre feet to supplementally irrigation 2.2 acres shaded in yellow above.

Application No. 37272 Permit No. 28548

CERT. 34037

IN NAME OF
GLADYS SCHULTZ
& GEORGE W. SAMPLE

Priority - Dec. 21, 196

Surveyed JUN. 24, 1965, by C. GARDNER