


RECEIVED

AUG 10 1981

WATER RESOURCES DEPT  
SALEM, OREGON

T. 38 S. R. 4 W. W.M.

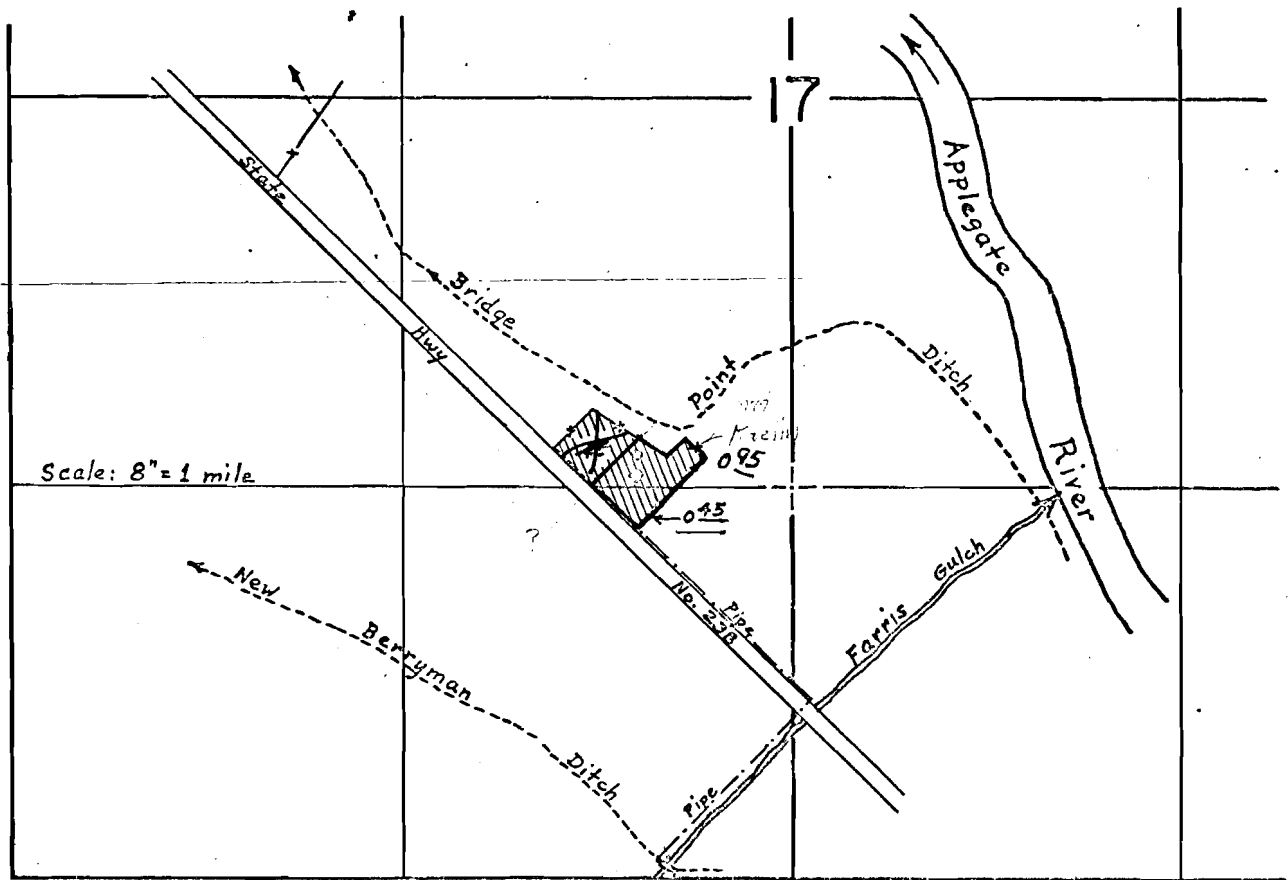

New Berryman Ditch diversion point is located  
1050' S. and 500' W. from the N 1/4 cor. Sec. 25

MAP TO ACCOMPANY - APPLICATION  
FOR: H. WILLIAM KAELIN FOR SUPPLEMENTAL  
IRRIGATION -  
FINAL PROOF SURVEY

Application No. 62188 UNDER  
Permit No. 46028

Application No. 40810 Permit No. 30406. CERT. 36887  
IN NAME OF

~~W. M. G. Joe F. Sullivan~~

Surveyed ~~Dec. 10, 1969~~, by ~~D. C. Hendrix~~