


T.39S. R.19E. W.M.

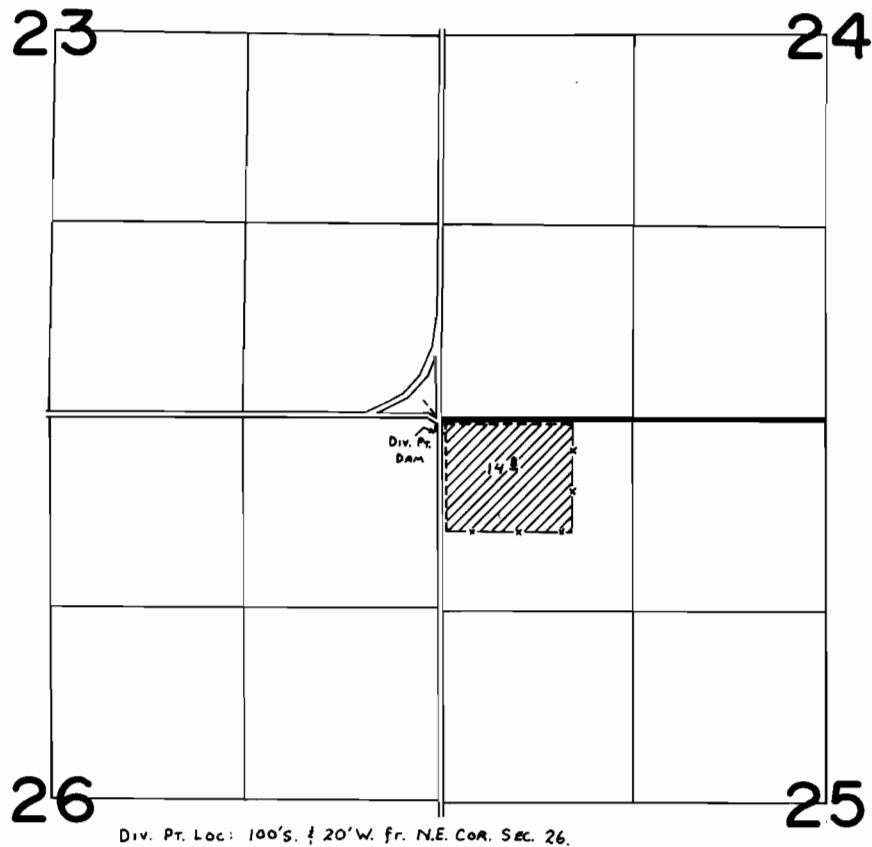

FINAL PROOF SURVEY
UNDER

Application No. 58711 Permit No. 44279
IN NAME OF

HELEN D. BUCK & FIRST INTERSTATE BANK OF OREGON

Surveyed JUNE 7 1980, by G. L. Hughes