


12
G-9021
53538

T.26S., R.16E., W.M.

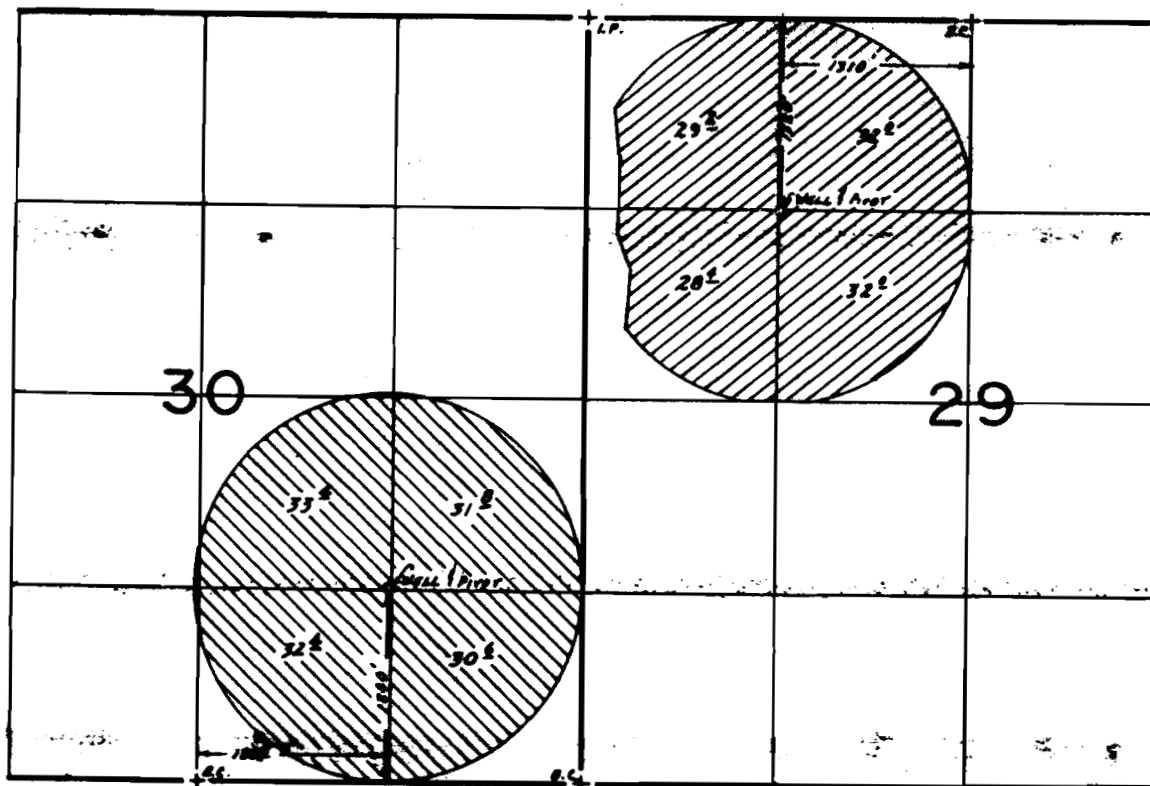

Scale: 1"=1320'

FINAL PROOF SURVEY
UNDER

Application No. G-9796 G-9021
G-10104.. Permit No. G-9135
IN NAME OF

GERALD ROY HANSON

Surveyed OCT. 30, 1984, by B.W. BISHOP