


T.26S., R.16E., W.M.

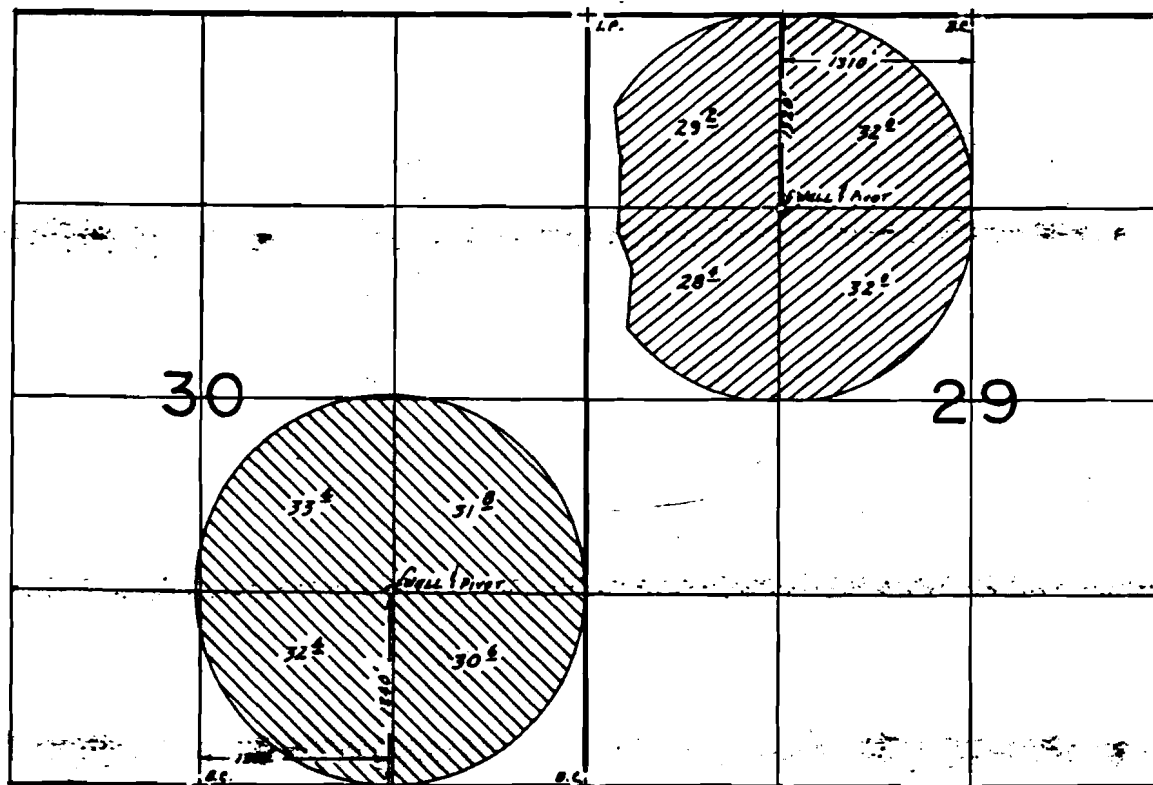

Scale: 1"=1320'

FINAL PROOF SURVEY UNDER

Application No. G-9796 Permit No. G-9021
G-10104 G-9145
IN NAME OF

GERALD ROY HANSON

Surveyed OCT. 30, 1984, by B.W. BISHOP

