


12
G-9068
53540

T.27S., R.17E., W.M.

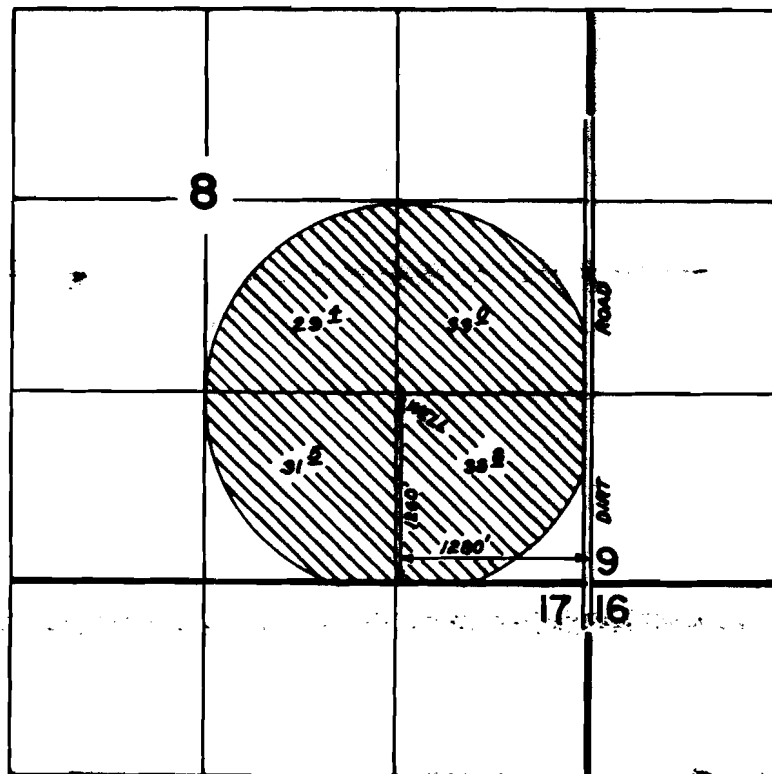

SCALE: 1" = 1320'

**FINAL PROOF SURVEY
UNDER**

Application No. G-9823... Permit No. G-9068...
IN NAME OF

GOLDEN RULE FARMS, INC.

Surveyed OCT. 23, 1984, by LESLIE OLSON