


T.9S.,R.2E.,W.M.

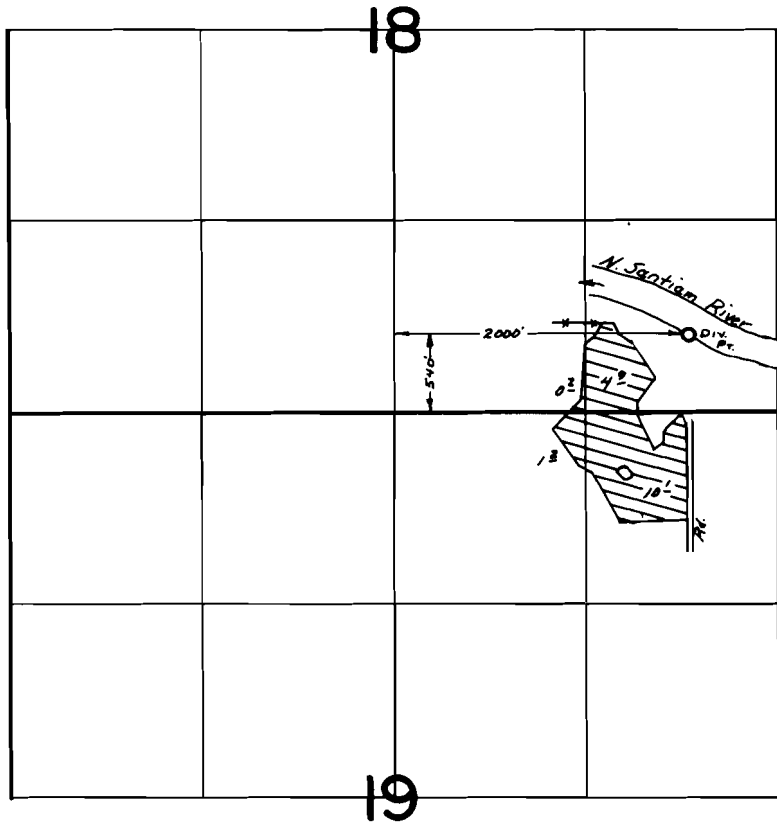

FINAL PROOF SURVEY
UNDER

Application No. 60240 Permit No. 45509.....
IN NAME OF

.....WALTER HAFNER.....

Surveyed July 27, 1981, by S.C. BROWN.....