



T. 6S.R.3W. W.M.

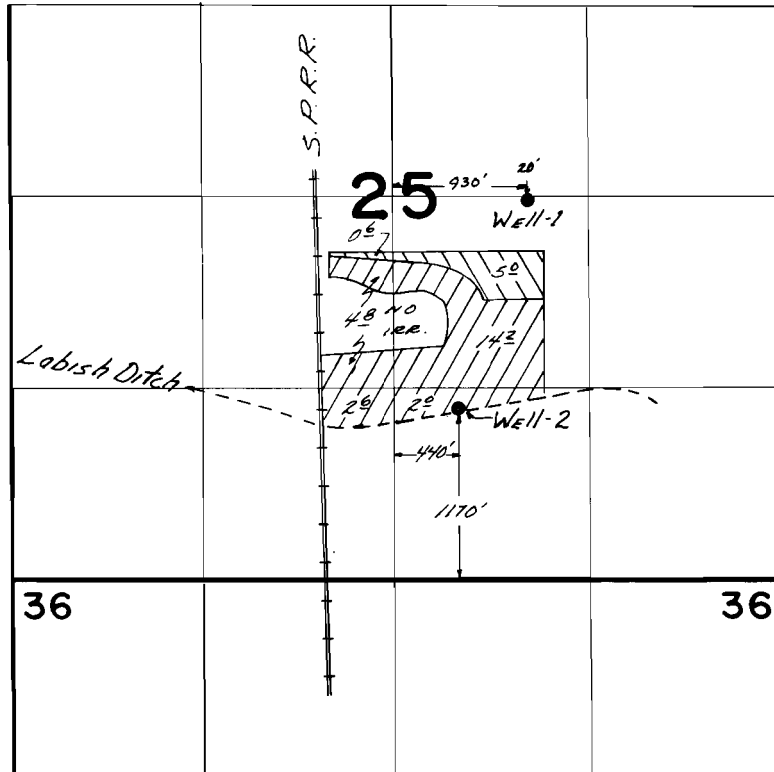

 - Irrigation from Well-1

 - Irrigation from Well-2

FINAL PROOF SURVEY UNDER

Application No. G-7310. Permit No. G-6757.
IN NAME OF

JAMES A. RICKARD

Surveyed Sept. 4, 1979, by C.R. RODRIGUEZ