


T. 9S., R. 1E., W.M.

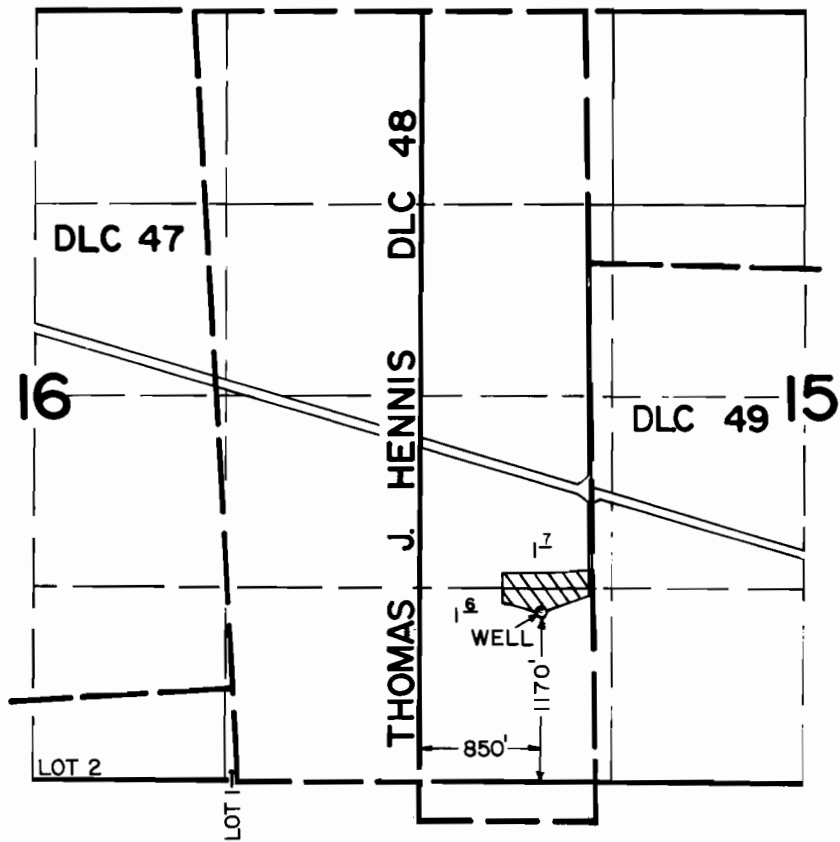

FINAL PROOF SURVEY
UNDER

Application No. G-7325 Permit No. G-6765....
IN NAME OF

DELMAR W. & RUTH A. FARR

Surveyed Oct 4, 1979, by S.C. BROWN.....