


G-4265
T6528
P.O.A
V48P360
53547

T. 1 S. R. 24 E. W. M.

SCALE: 1" = 1320'

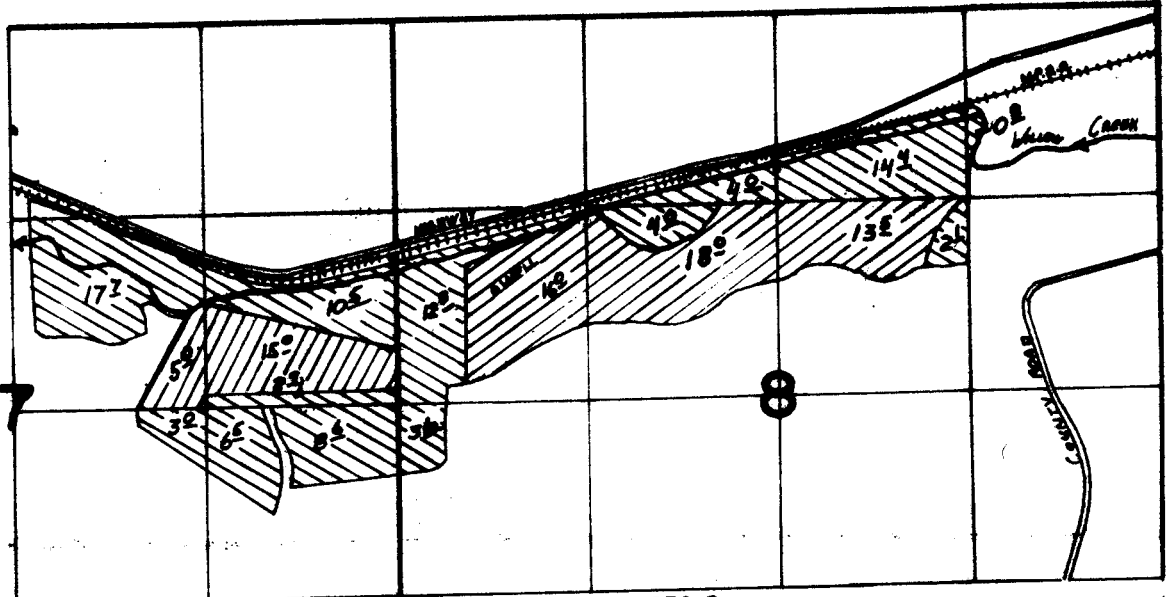

WELL LOCATED 1860' S. AND 580' E. FROM NW COR. SEC. 8



PRIMARY



SUPPL. CERT. 148



SUPPL. CERT. 159

FINAL PROOF SURVEY UNDER

Application No. G-4527 Permit No. G-4265
IN NAME OF

ELMER S. & LORRAINE M. LADD

Surveyed JUNE 24, 1978, by R. BARWIN

372-93 VLC

RECORD 1-4-85-15