


T. 3 N., R. 10 W., W.M.

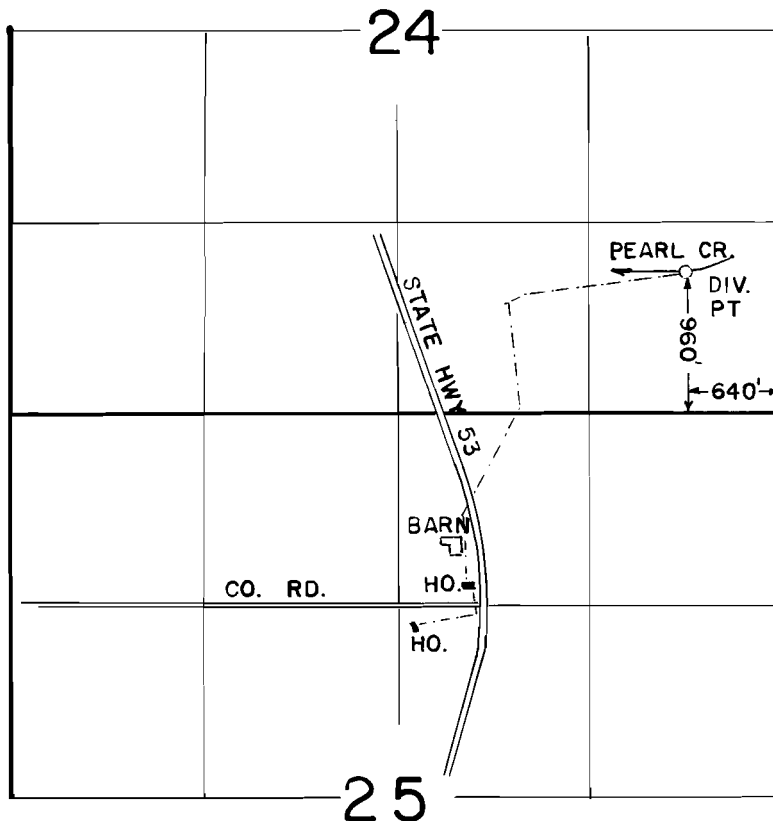

N

SCALE
1" = 1320'

FINAL PROOF SURVEY
UNDER

Application No. 57775 Permit No. 43859

IN NAME OF

MYERS BROS.

Surveyed MAY 23 1984, by P. PAGTER