


G-6792⁵
53551

T. 5N. R. 28E. W.M.

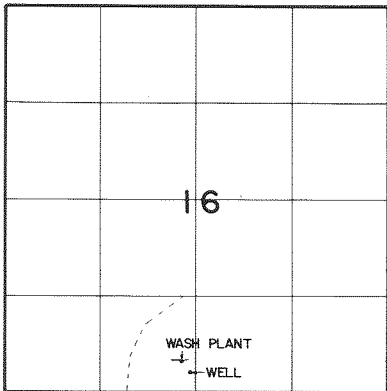

WELL LOCATED 270' N & 60' W. FROM S 1/4 COR. SEC 16

FINAL PROOF SURVEY
UNDER

Application No. G-6792. Permit No. G-6792.
IN NAME OF

.....**ROGERS CONSTRUCTION CO.**.....

Surveyed 7-7..... 1978., by R. BARKIN.....
6-16 1980 V. CHURCH