


G-9977<sup>5</sup>  
53556

T. 58 & 6N., R. 35E., W. M.

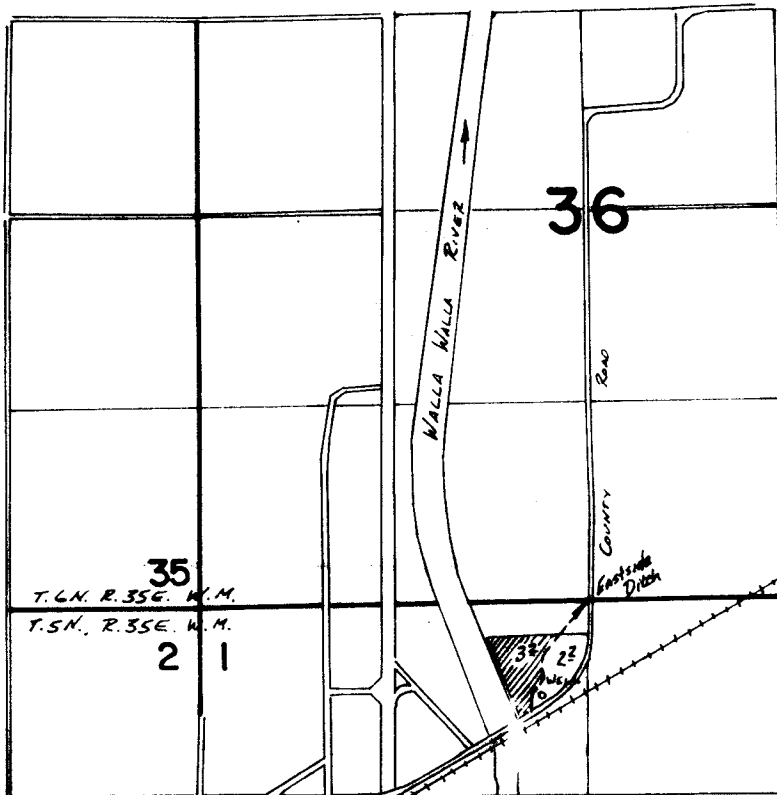

WELL LOC: 630' S. & 310' W. FROM N<sup>1</sup>/<sub>4</sub> COR. SEC. 1

### FINAL PROOF SURVEY

UNDER

Application No. G:10484 Permit No. G:9977...  
IN NAME OF

.....ALICE.....BINGMAN.....

Surveyed 4-30..... 1984., by V.L. Church.....

SCALE: 1" = 1320'