

R-64827

T.36 S.


R.6E.

PRIMARY LODGE

RESERVOIR

4-MILE QUARRY POND
NW 1/4 SE 1/4 SEC 18

RESERVOIR
NE 1/4 NW 1/4 SEC 26

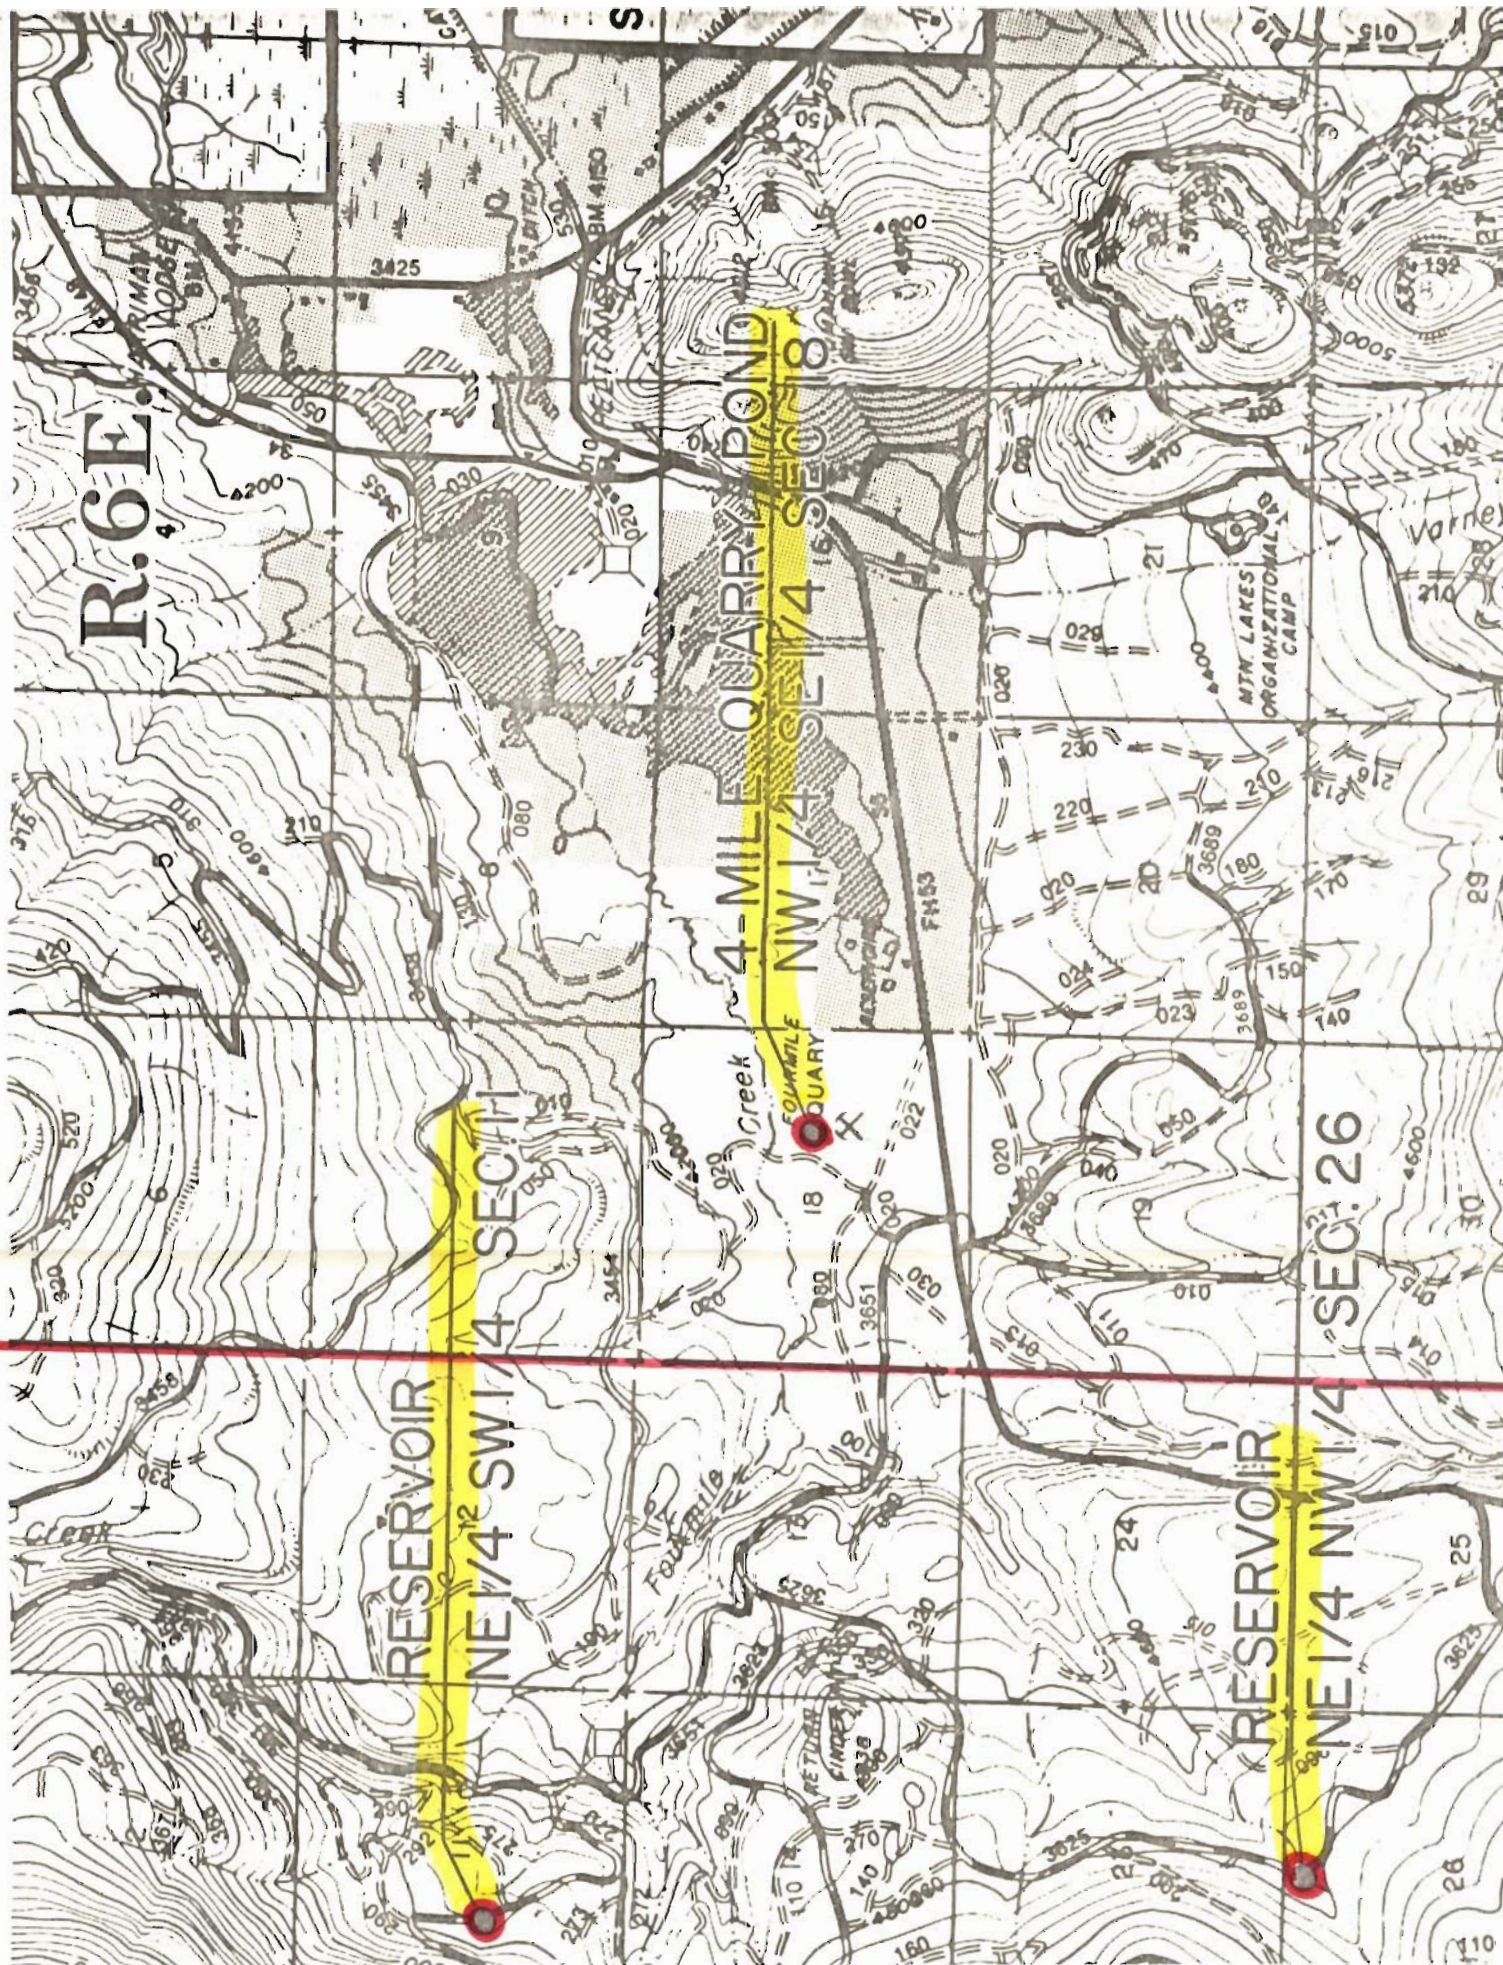

WATER