


R-64889 9948
53563

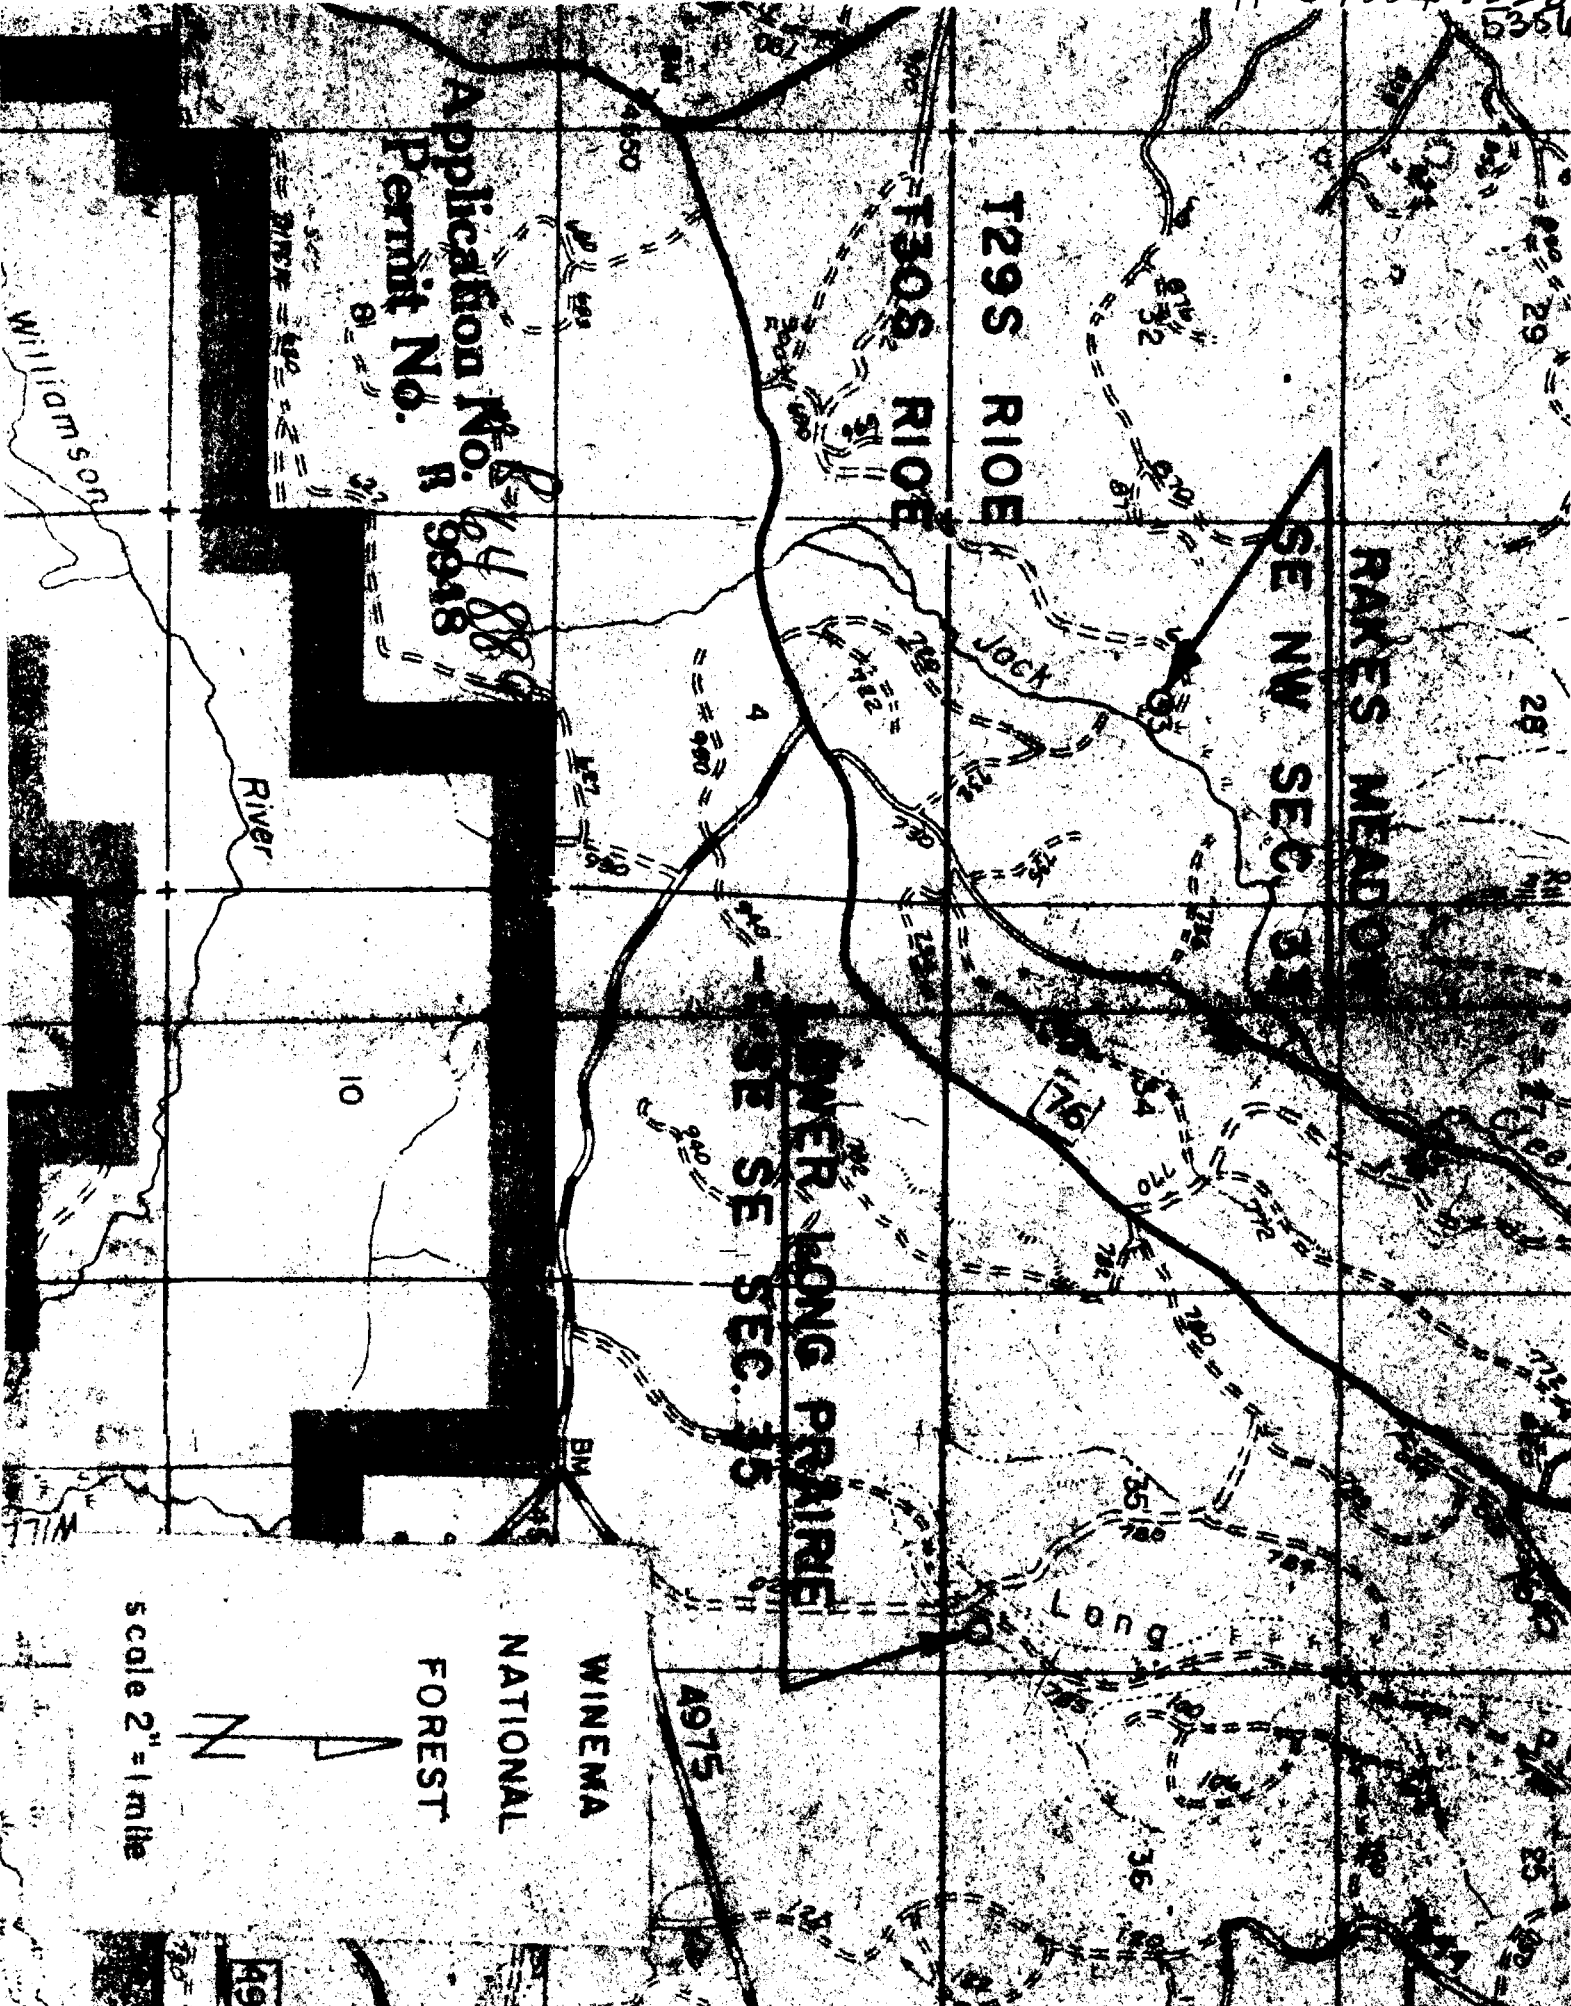

Application No. R-64889
Permit No. R 9948

T295 RIOE


T308 RIOE

SE NW SEC 33

SE SE SEC 35



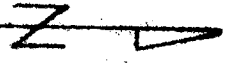

Scale 2" = 1 mile

WINEMA
NATIONAL
FOREST

49