


R 10380 11  
53595

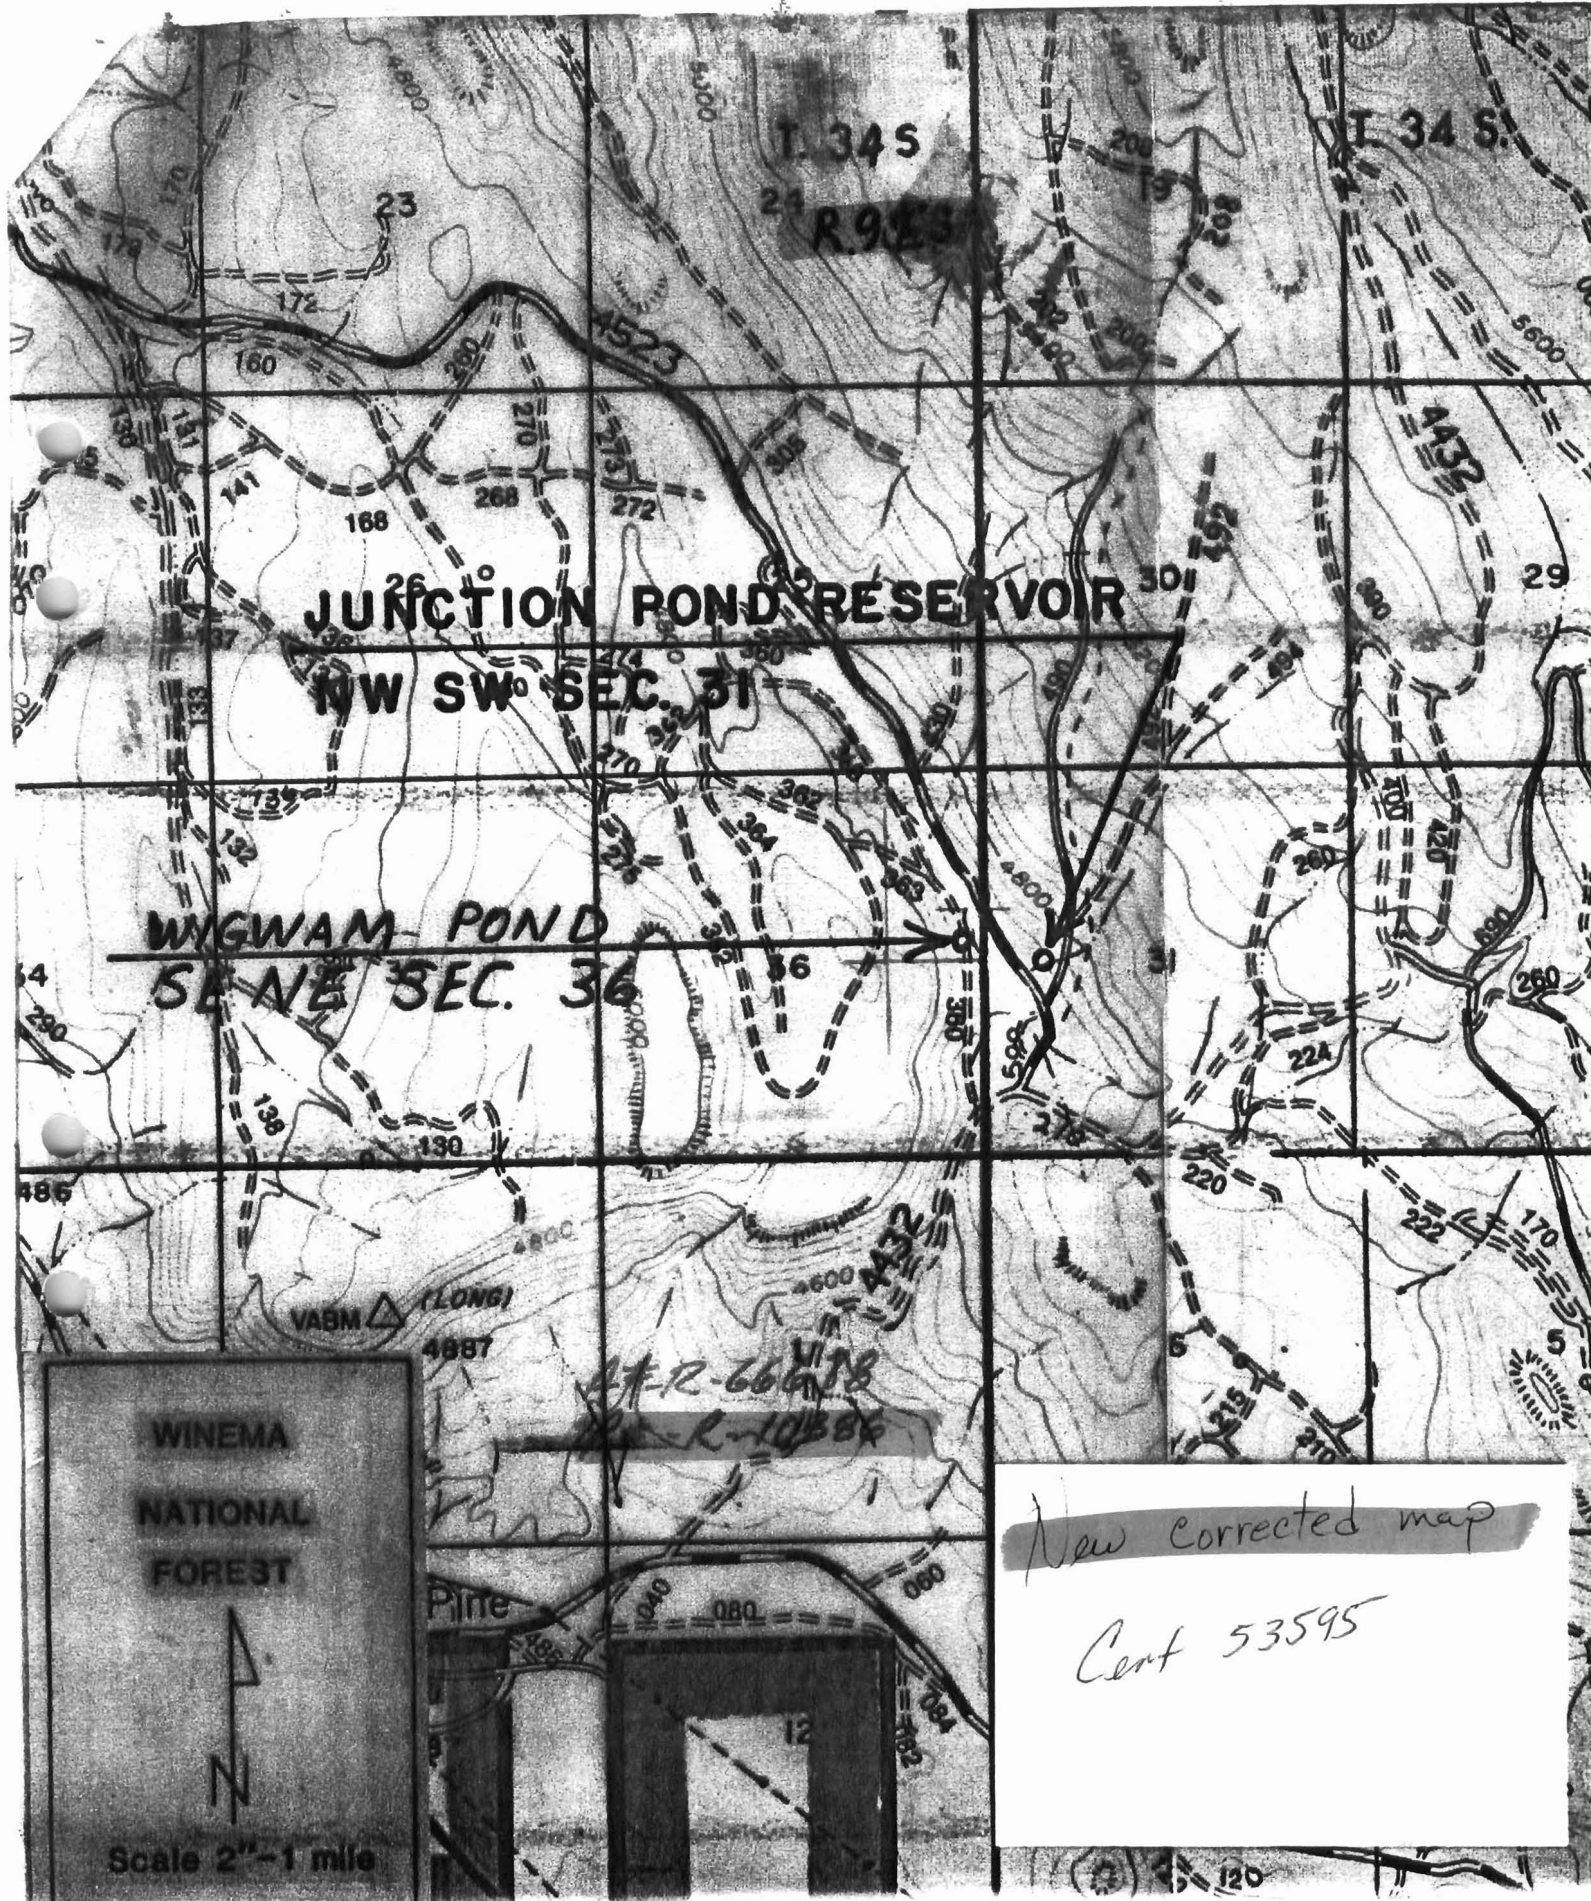

JUNCTION POND RESERVOIR  
NW SW SEC. 31

WIGWAM POND  
SE NE SEC. 36

New corrected map  
Cent 53595

WINEMA  
NATIONAL  
FOREST  
N  
Scale 2" = 1 mile