

K 10387  
T 66671  
53596


Application No.  
Permit No.

WINEMA

WINEMA  
NATIONAL  
FOREST



Scale 2" = 1 mile

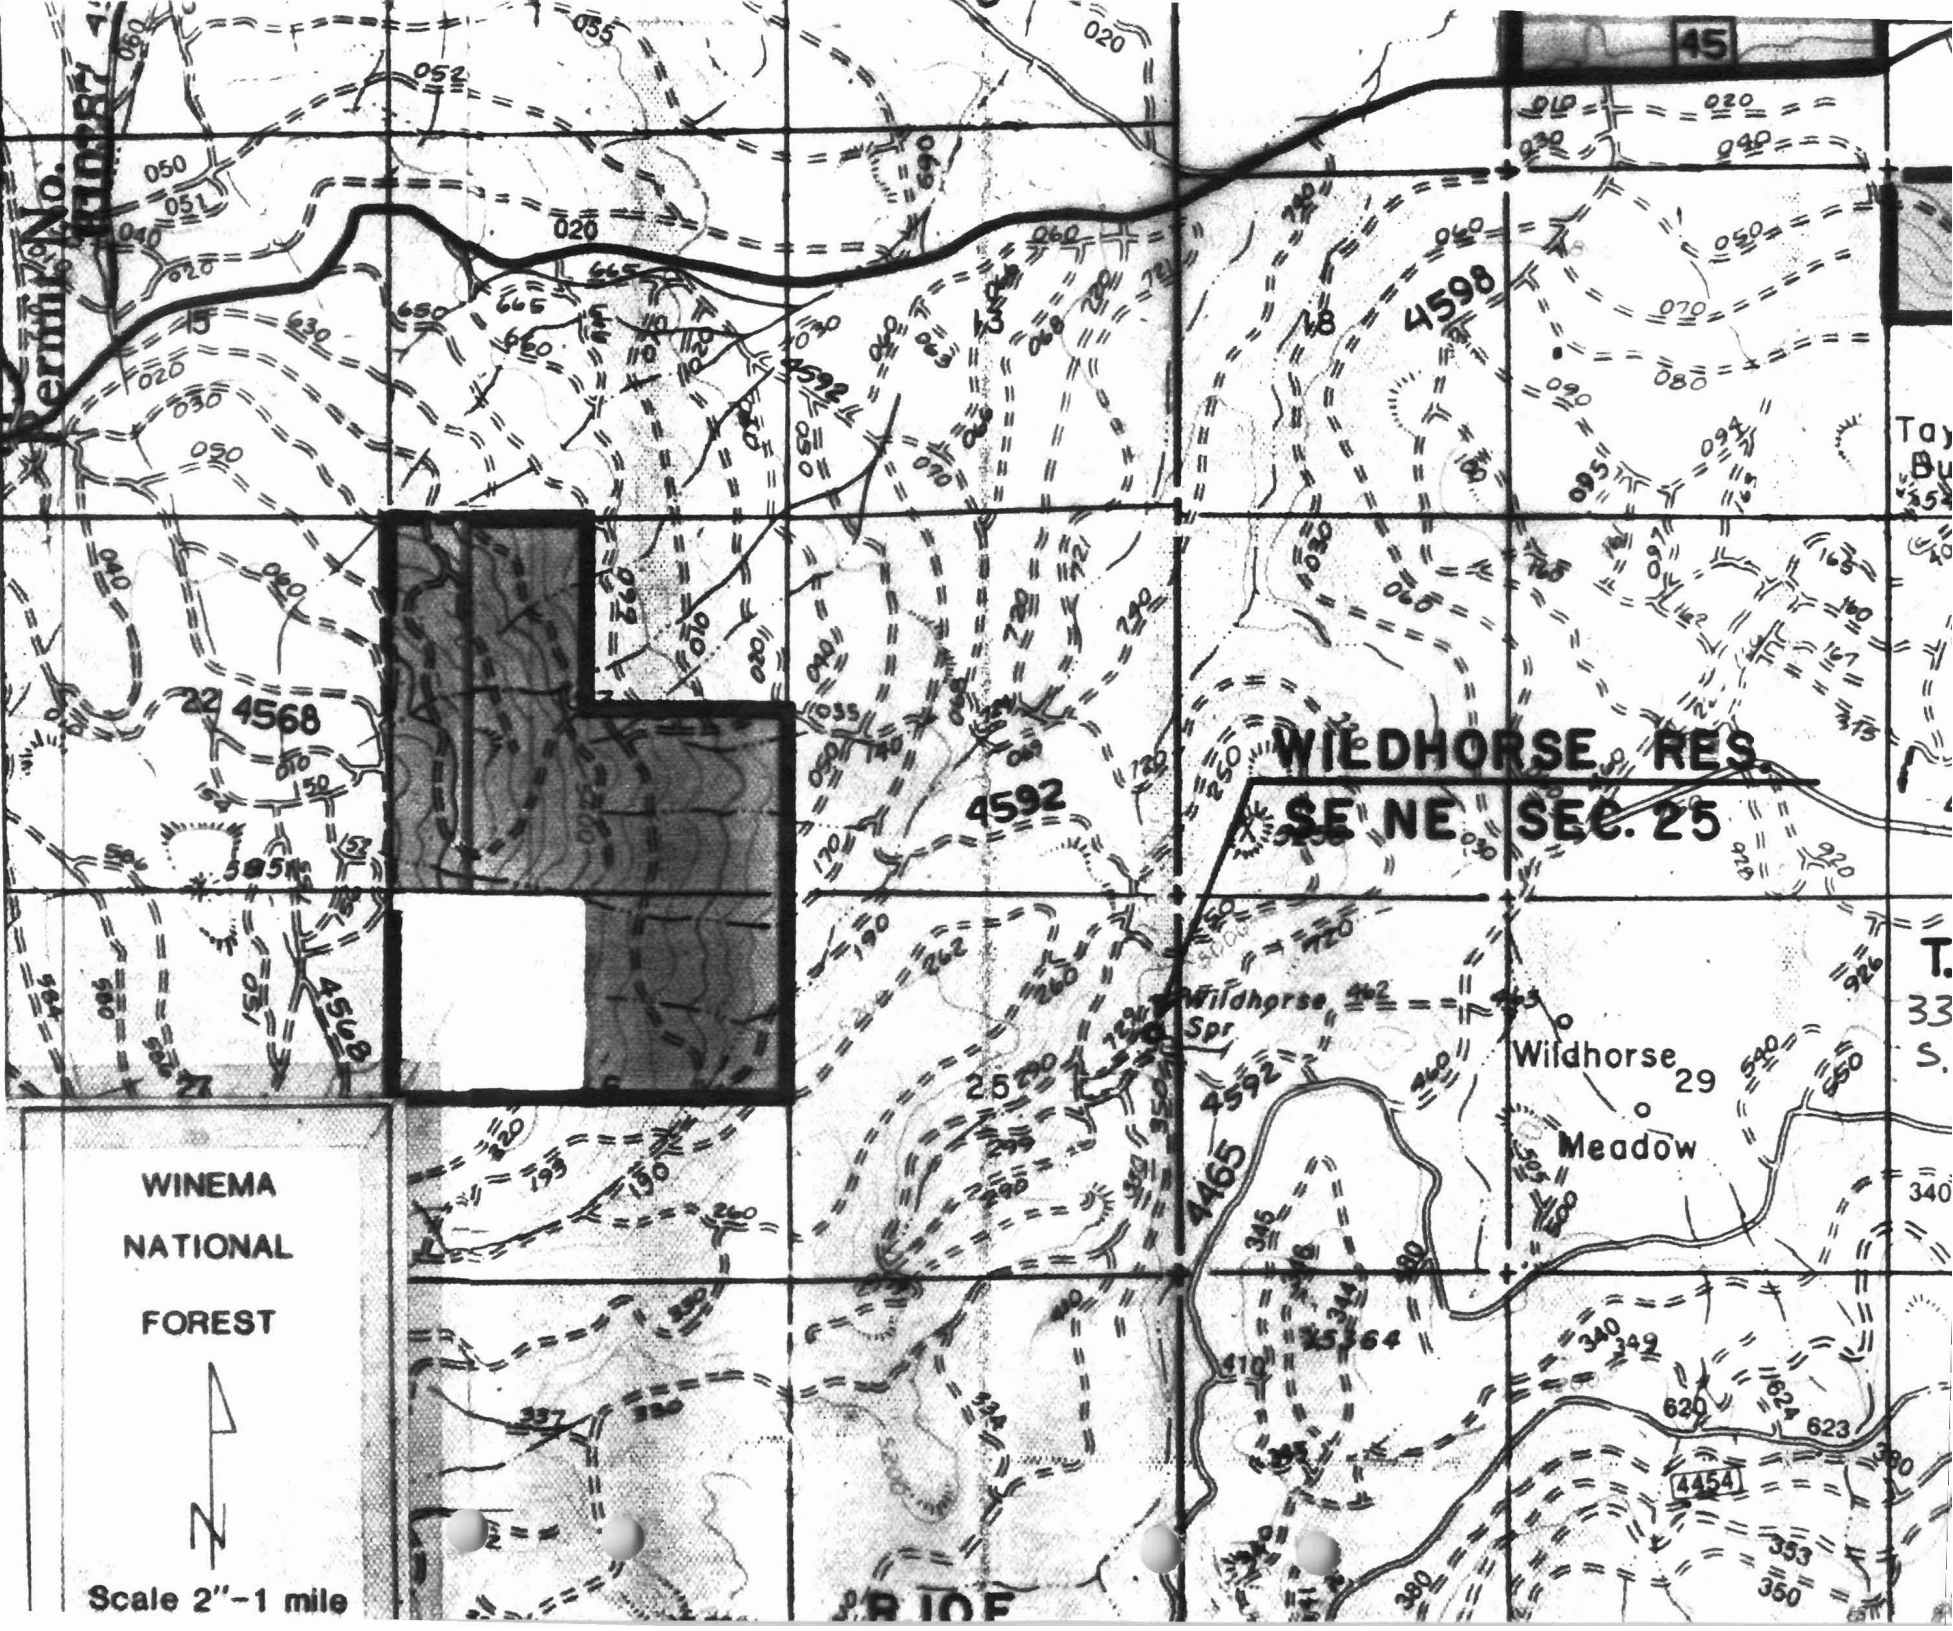

WILDHORSE RES.  
SE NE SEC. 25

Wildhorse Spr

Wildhorse Meadow

4568

4592

4598

4454

45

Tay  
Bu  
354

T.  
33  
S.

340

BRIDGE