


~~1-53609~~

~~P-29229~~ 23609

P-29230

S.O. VOL. 39 P. 434

T.9S. R.27E. W.M.

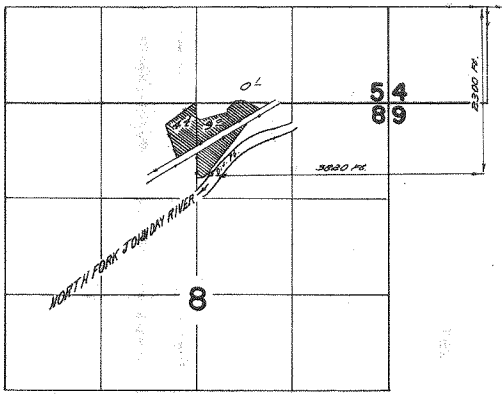

FINAL PROOF SURVEY UNDER

Application No. 39229 Permit No. 29230
IN NAME OF

W.E. MILLER RANCHES, INC. &/or
WARREN E. & EARL F. MILLER
Surveyed May 1st, 1968, by W.S. Reynolds