

The "Pier" right


RECEIVED

OCT 18 1996

T. 14 S. R. 12 E. W.M.

WATER RESOURCES DEPT.
SALEM, OREGON

Lands to be "diminished"

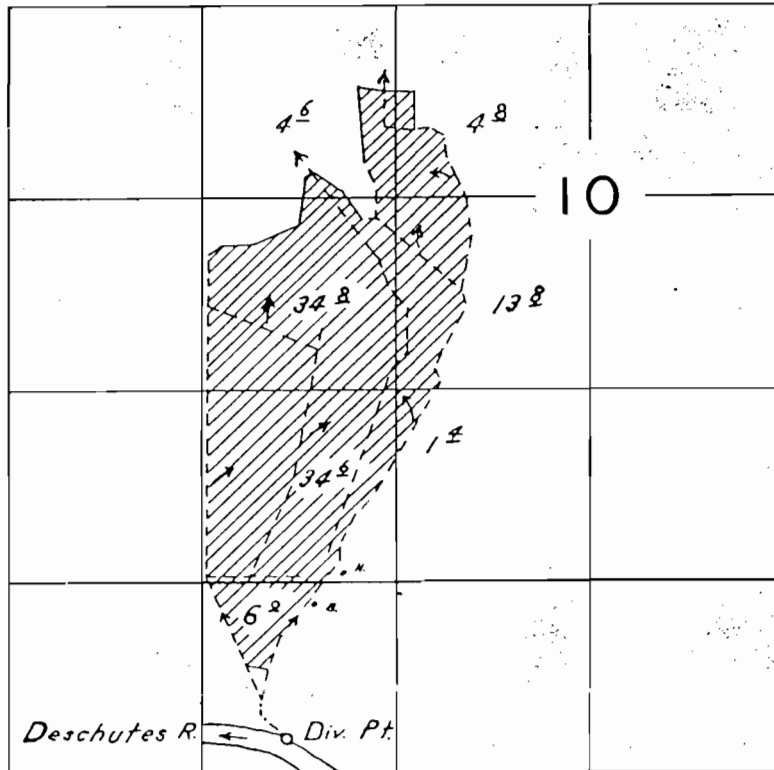

FINAL PROOF SURVEY
UNDER

Application No. 24709 Permit No. 19418
IN NAME OF

Deschutes Farmers Co-op

Surveyed Oct. 29, 1958, by W.N. Perry

T 7636