


T. 27 S. R. 4 W. W. M.

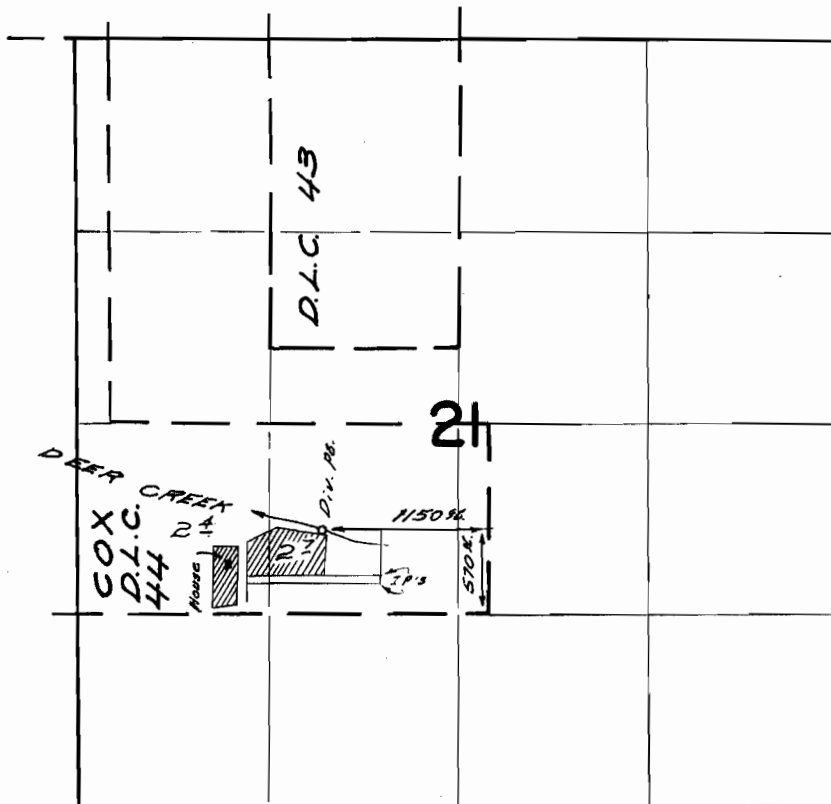

**FINAL PROOF SURVEY**  
UNDER

Application No. 37864 Permit No. 28221  
IN NAME OF

Festus L. Merry

Surveyed April 17, 1967, by W. J. Puppert  
June 27, 1968