


T.36S.R.4W.W.M.

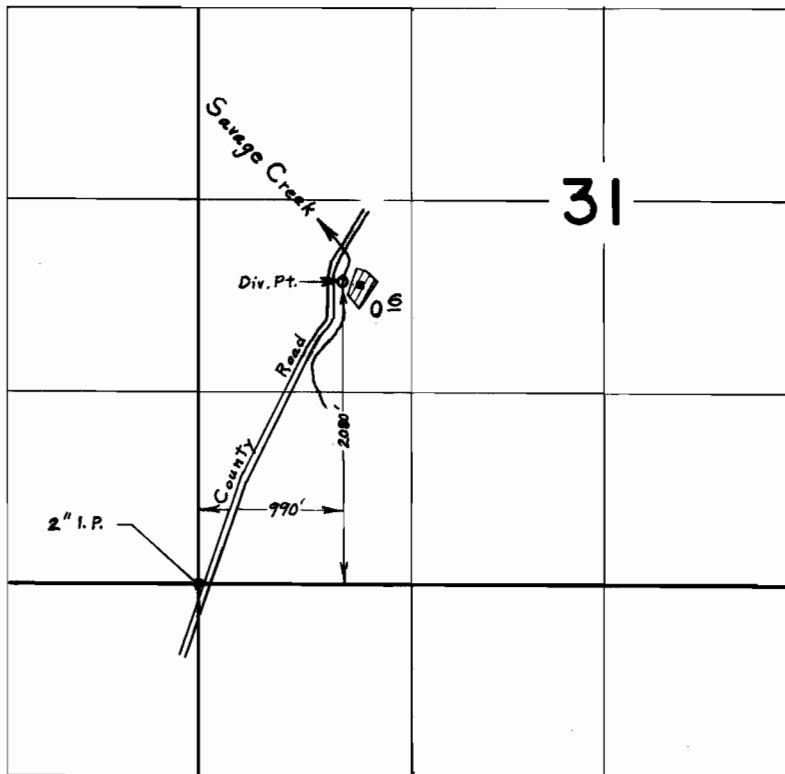

**FINAL PROOF SURVEY**  
UNDER

Application No. 39059 Permit No. 29089  
IN NAME OF

MARSHALL BULLARD

Surveyed June 7, 1966, by R. E. Gould