


**T.7S.R.1W.W.M.**

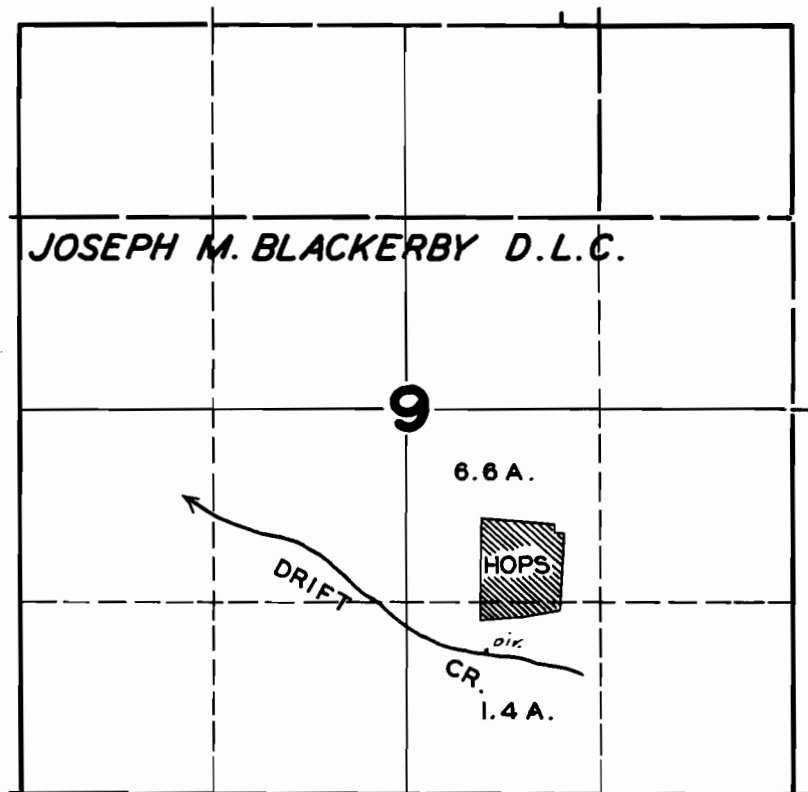

**FINAL PROOF SURVEY  
UNDER**

**Application No. 20282 Permit No. 15822**

**IN NAME OF**

**MONROE HANSON**

**Surveyed OCT. 25 1947, by JAS. E. BUNNELL**