


T.5 N., R.27 & 28 E., W.M.

FINAL PROOF SURVEY

UNDER
APPL. 56979 PER. 42856

IN NAME OF
L AND L FARMS INC.
SURVEYED MAY 29, 1983 BY: V.L. CHURCH...

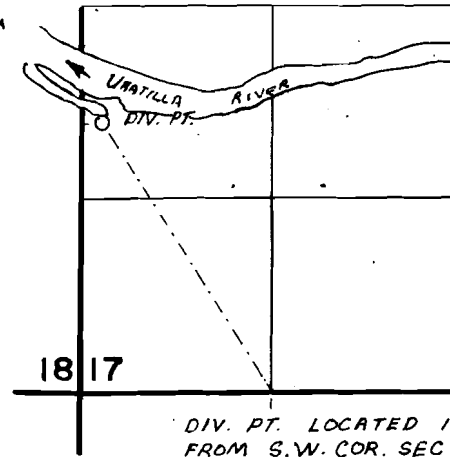

DIV. PT. LOCATED 186° NORTH AND 150° EAST
FROM S.W. COR. SEC. 17



SCALE: 1" = 1320'

R.27E. R.28E.

