



# T. 3N., R. 34E., W.M.

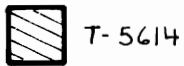

T-5614

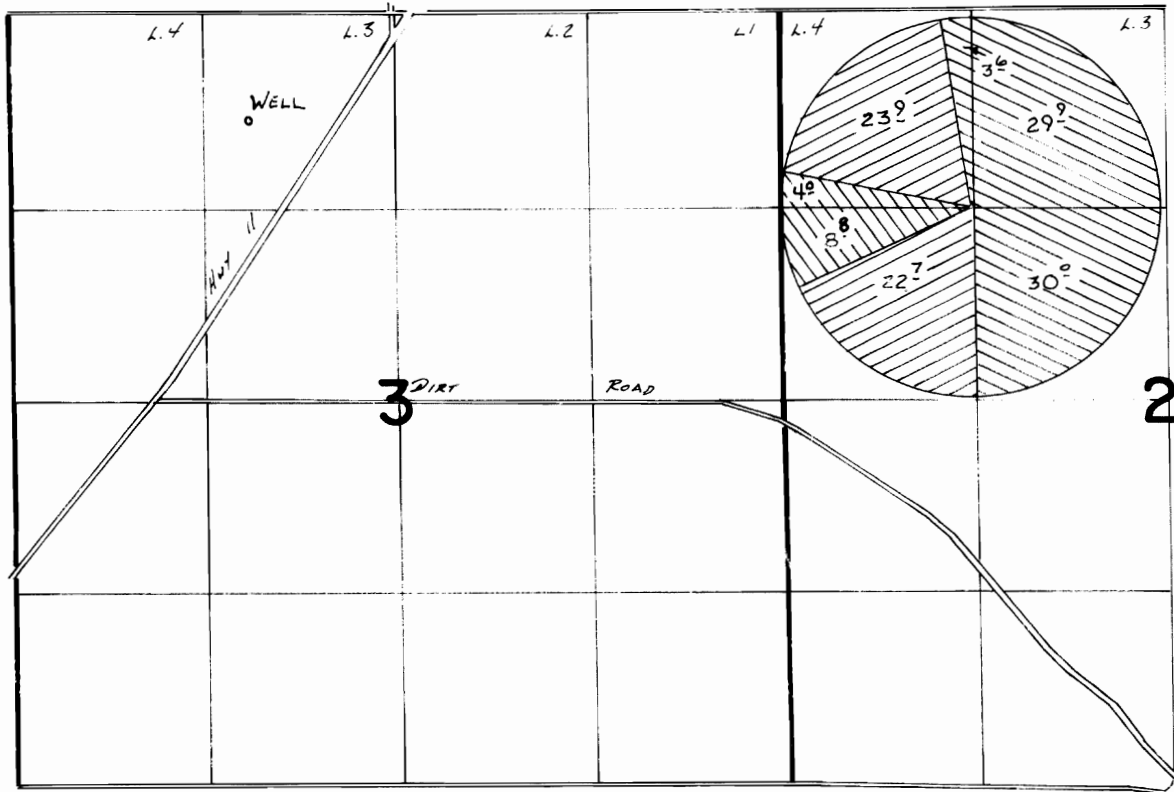

T-5615



T-5616

## FINAL PROOF SURVEY UNDER

**TRANSFERS 5614, 5615, 5616**  
IN NAME OF

**B.L. DAVIS RANCH, INC.**

Surveyed July 2, 1985, by V. L. Church



SCALE: 1" = 1320'