


# T.9S. R.27E. W.M.

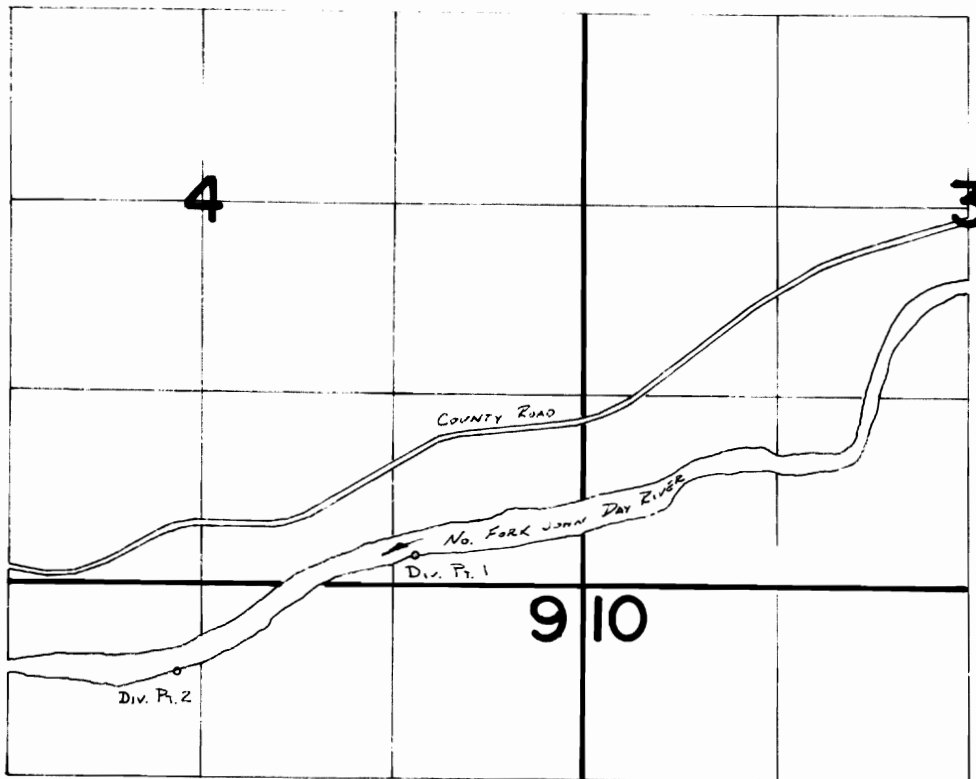

Div. Pt. 1 LOCATED 210' N. & 1150' W. FROM SE COR. SEC 4  
Div. Pt. 2 LOCATED 610' S. & 2790' W. FROM NE COR. SEC 9


## FINAL PROOF SURVEY UNDER

TRANSFER 5389  
IN NAME OF

**DAVID & LINDA HAASE**

Surveyed *4-11*..... 1985., by *V. L. Church*.....

T. 9 S. R. 27 E. W. M.

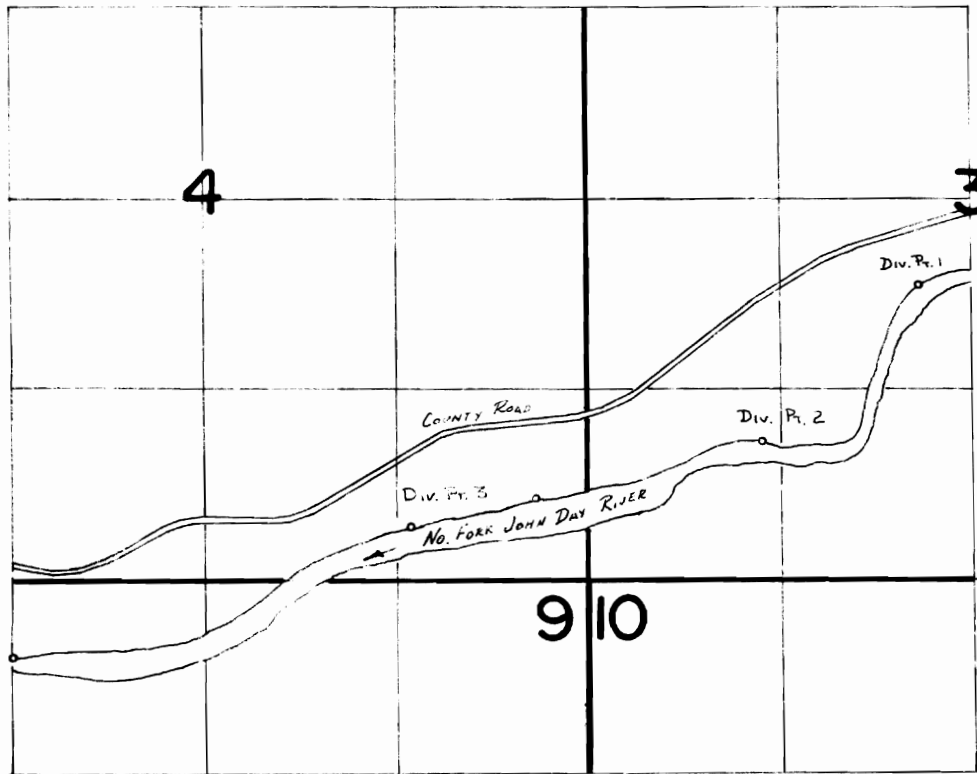

Div. Pt. 1 Located 2030' N & 2270' E. FROM }  
Div. Pt. 2 Located 950' N. & 1200' E. FROM } SW COR. SEC. 3  
Div. Pt. 3 Located 370' N. & 1210' W. FROM }

SCALE: 1" = 1320'

**FINAL PROOF SURVEY**  
UNDER

TRANSFER 5335, 5339

IN NAME OF

J. DONALD CAPON

Surveyed APRIL 10, 1985, by V. L. Church.....